

STATE ENGINEER
Salem, Oregon

Well Record


STATE WELL NO. 11/5W-24M
COUNTY Benton
APPLICATION NO. GR-4120

3918

OWNER: Cecil F. Rodgers MAILING ADDRESS: 2446 N. Ninth St.

LOCATION OF WELL: Owner's No. _____ CITY AND STATE: Corvallis, Oregon

NW ¼ SW ¼ Sec. 24 T. 11 S., R. 5 W., W.M.
Bearing and distance from section or subdivision
corner 3300' S. & 335' E. from NW Cor. Sec. 24

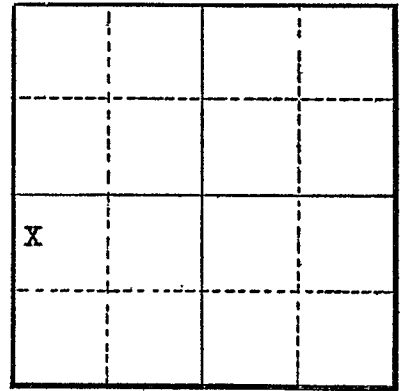

Section 24

Altitude at well _____

TYPE OF WELL: Drilled Date Constructed 9/54
Depth drilled 57 ft. Depth cased 54 ft.

CASING RECORD:

6 inch casing set to 54 ft.

FINISH:

Lower 5 ft. perforated, burned slots 8 x 2½ long from 49 to 54 feet

AQUIFERS:

WATER LEVEL:

18 feet below surface

PUMPING EQUIPMENT: Type Myers jet 3/4" horse H.P. 3/4
Capacity 20 G.P.M.

WELL TESTS:

Drawdown 10 ft. after _____ hours 26 G.P.M.
Drawdown _____ ft. after _____ hours _____ G.P.M.

USE OF WATER Irrigation Temp. _____ °F., 19

SOURCE OF INFORMATION Well Registration Statement Cert. # GR-3703

DRILLER or DIGGER James Beck

ADDITIONAL DATA:

Log _____ Water Level Measurements _____ Chemical Analysis _____ Aquifer Test _____

REMARKS: