

STATE ENGINEER  
Salem, Oregon

# Well Record

STATE WELL NO. 11/5W-25D  
COUNTY BENTON  
APPLICATION NO. 3970-GR-2598

OWNER: Arnold Barzee


MAILING ADDRESS: Rt. 1, Box 107

LOCATION OF WELL: Owner's No. \_\_\_\_\_

CITY AND STATE: Corvallis, Oregon

NW 1/4 NW 1/4 Sec. 25 T. 11 N. 5 E. W.M.

Bearing and distance from section or subdivision corner 685' W. and 5336' N. of SW Cor. DLC #51.

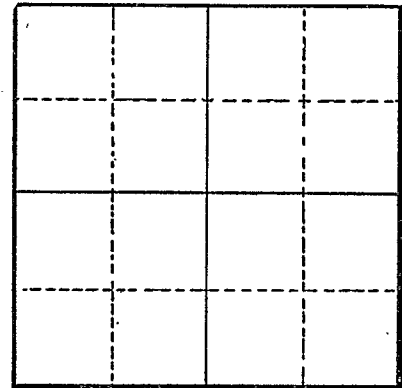

Section \_\_\_\_\_

Altitude at well \_\_\_\_\_

TYPE OF WELL: Drilled Date Constructed 1952

Depth drilled 48 Depth cased 48

### CASING RECORD:

8-inch

### FINISH:

10' 8 rows Mill perforations from 35 to 46

### AQUIFERS:

Clay, sand, and gravel

### WATER LEVEL:

20-feet

PUMPING EQUIPMENT: Type Fairbanks Morse H.P. 10  
Capacity 150 G.P.M.

### WELL TESTS:

Drawdown 13 ft. after \_\_\_\_\_ hours Pumping 150 G.P.M.

Drawdown \_\_\_\_\_ ft. after \_\_\_\_\_ hours \_\_\_\_\_ G.P.M.

USE OF WATER Irrigation Temp. \_\_\_\_\_ °F. \_\_\_\_\_, 19\_\_\_\_

SOURCE OF INFORMATION GR-2465

DRILLER or DIGGER \_\_\_\_\_

### ADDITIONAL DATA:

Log  Water Level Measurements \_\_\_\_\_ Chemical Analysis \_\_\_\_\_ Aquifer Test \_\_\_\_\_

### REMARKS:

Clay	0	30	30	30
Sand	30	33	3	33
Gravel bearing water	33	47	14	47
Clay			1	48