

STATE ENGINEER
Salem, Oregon

Well Record

STATE WELL NO. 11/5W - 25Q
COUNTY BENTON
APPLICATION NO. GR-2222

OWNER: Herman T. Kessler


MAILING ADDRESS: Box 362

LOCATION OF WELL: Owner's No. _____

CITY AND STATE: Corvallis, Oregon

SW 1/4 SE 1/4 Sec. 25 T. 11 S., R. 5 W., W.M.

Bearing and distance from section or subdivision corner 1610' W. and 350' S.

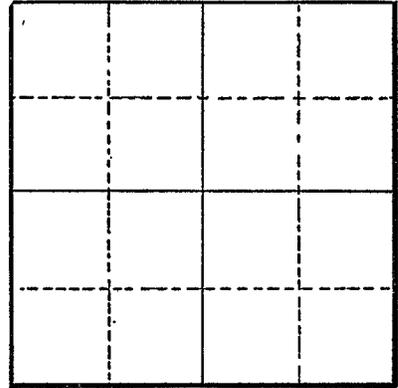

Section _____

Altitude at well _____

TYPE OF WELL: Driven Date Constructed 1942

Depth drilled 28 Depth cased _____

CASING RECORD:

FINISH:

AQUIFERS:

Silt, sand and gravel

WATER LEVEL:

8-Feet

PUMPING EQUIPMENT: Type Denver Gardner H.P. 3
Capacity 150 G.P.M.

WELL TESTS:

Drawdown 8 ft. after _____ hours Pumping 165 G.P.M.
Drawdown _____ ft. after _____ hours _____ G.P.M.

USE OF WATER Irrigation Temp. _____ °F. _____, 19.

SOURCE OF INFORMATION GR-2127

DRILLER or DIGGER Owner

ADDITIONAL DATA:

Log X Water Level Measurements _____ Chemical Analysis _____ Aquifer Test _____

REMARKS:

River silt 12'
Sand 8'
Gravel 10' 28'