

STATE ENGINEER  
Salem, Oregon

# Well Record

Benton STATE WELL NO. 11/5W-26M  
3976 COUNTY Benton  
APPLICATION NO. GR-2929

OWNER: Martin H. Baker

MAILING ADDRESS: 1399 E. Grant Street


LOCATION OF WELL: Owner's No.

CITY AND STATE: Corvallis, Oregon

NW 1/4 SW 1/4 Sec. 26 T. 11 S, R. 5 W, W.M.

Bearing and distance from section or subdivision

corner N. 25° E. 1850'

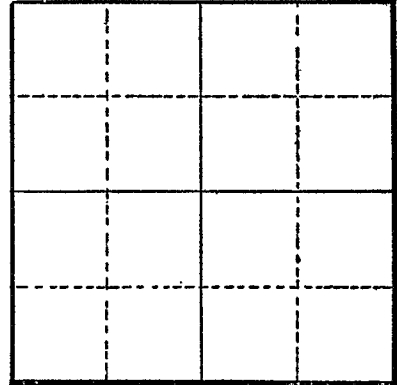

Section

Altitude at well

TYPE OF WELL: drilled Date Constructed 1948

Depth drilled 50' Depth cased 40'

### CASING RECORD:

8"

### FINISH:

perforations from 28 to 40

### AQUIFERS:

### WATER LEVEL:

30'

PUMPING EQUIPMENT: Type Fairbanks Morse Pomona Turbine 3" H.P. 7 1/2  
Capacity 150 G.P.M.

### WELL TESTS:

Drawdown ..... ft. after ..... hours ..... G.P.M.  
Drawdown ..... ft. after ..... hours ..... G.P.M.

USE OF WATER Irrigation Temp. °F. 19

SOURCE OF INFORMATION GR-2881

DRILLER or DIGGER Charles Schaffer

### ADDITIONAL DATA:

Log ..... Water Level Measurements ..... Chemical Analysis ..... Aquifer Test .....

### REMARKS: