

STATE ENGINEER
Salem, Oregon

Well Record

Bent
3997
STATE WELL NO. 11/5W-26D(1)
COUNTY Benton
APPLICATION NO. GR-298


OWNER: John S. Brandis

MAILING ADDRESS: Corvallis, Oregon
CITY AND STATE:

LOCATION OF WELL: Owner's No. 1

NW 1/4 NW 1/4 Sec. 26 T. 11 S., R. 5 W., W.M.

Bearing and distance from section or subdivision corner 379' N. and 35' W. of SW corner of Herman C. Lewis DLC #47

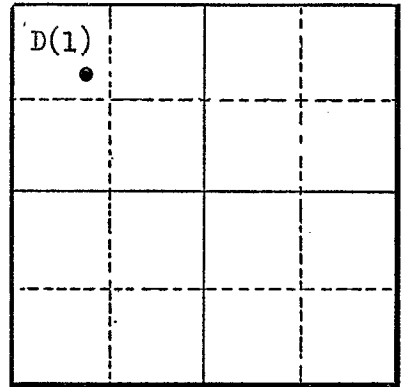

Section 26

Altitude at well 250' Interpolated

TYPE OF WELL: Drilled Date Constructed 1953

Depth drilled 55 Depth cased 50

CASING RECORD:

10-inch casing from 0 to 50 feet

FINISH:

unknown

AQUIFERS:

unknown

WATER LEVEL:

38' below land surface

PUMPING EQUIPMENT: Type Berkeley - Turbine 4" H.P. 25

Capacity 600 G.P.M.

WELL TESTS:

Drawdown ? ft. after hours G.P.M.
Drawdown ft. after hours G.P.M.

USE OF WATER Irrigation 78.78 acres Temp. °F., 19

SOURCE OF INFORMATION Registration Statement GR-298

DRILLER or DIGGER Schaffer - Philomath, Oregon

ADDITIONAL DATA:

Log No Water Level Measurements Chemical Analysis Aquifer Test

REMARKS: