

STATE ENGINEER  
Salem, Oregon

# Well Record

*Bent*  
*4210*

STATE WELL NO. 11/5W-35G  
COUNTY BENTON  
APPLICATION NO. GR-2335

OWNER: H. H. HEHNKE


MAILING ADDRESS: 1130 N 2nd St

LOCATION OF WELL: Owner's No.

CITY AND STATE: Corvallis, Oregon

SW 1/4 NE 1/4 Sec. 35 T. 11 S., R. 5 W., W.M.

Bearing and distance from section or subdivision corner 1205' S 28° 38' E of the SW corner of the John Stewart DLC No 49

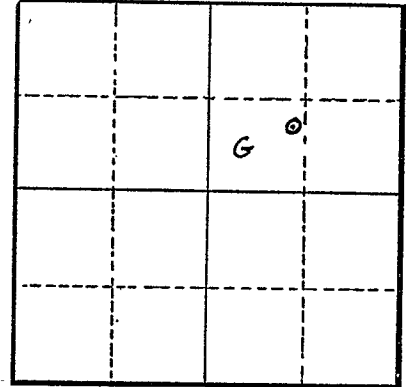

Section 35

Altitude at well

TYPE OF WELL: Drilled Date Constructed 1944

Depth drilled 42' Depth cased 42'

CASING RECORD:

4-inch

FINISH:

Perforated casing

AQUIFERS:

WATER LEVEL:

16-20 feet

PUMPING EQUIPMENT: Type Impeller type Meyers Pump  
Capacity 20 G.P.M.

H.P. 1

WELL TESTS:

Drawdown	ft. after	hours	G.P.M.
Drawdown	ft. after	hours	G.P.M.

USE OF WATER Irrigation Temp. °F., 19

SOURCE OF INFORMATION GR-3901

DRILLER or DIGGER Knut Knudson

ADDITIONAL DATA:

Log NA Water Level Measurements Chemical Analysis Aquifer Test

REMARKS: