

STATE ENGINEER
Salem, Oregon

Well Record

STATE WELL NO. 11/5W-35R(1)
COUNTY Benton
APPLICATION NO. GR-848

4223

OWNER: Western Oregon Packing Corp.


MAILING ADDRESS:

LOCATION OF WELL: Owner's No.

CITY AND STATE:

SE 1/4 SW 1/4 Sec. 35 T. 11 N. S. R. 5 W., W.M.

Bearing and distance from section or subdivision corner 2175' E. & 2250' S. from NW corner Section 35

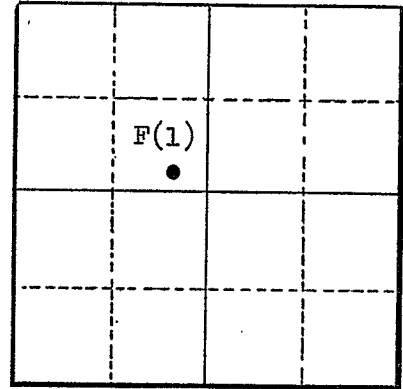

Section 35

Altitude at well 242

TYPE OF WELL: Drilled Date Constructed 1940

Depth drilled 48 Depth cased 48'

CASING RECORD:

8" 0 - 48'

FINISH:

Last 12' slit

AQUIFERS:

WATER LEVEL:

16'

PUMPING EQUIPMENT: Type Fairbanks Morse 4" H.P. 10
Capacity 200 G.P.M. Fairbanks Morse

WELL TESTS:

Drawdown 0 ft. after 200 hours G.P.M.
Drawdown ft. after hours G.P.M.

USE OF WATER Industrial Temp. °F. 19

SOURCE OF INFORMATION

DRILLER or DIGGER A. M. Janssen Drilling Co. Aloha, Oregon

ADDITIONAL DATA:

Log NA Water Level Measurements Chemical Analysis Aquifer Test

REMARKS: