

STATE ENGINEER
Salem, Oregon

Well Record


Bent
4230

STATE WELL NO. 11/5W-36G
COUNTY BENTON
APPLICATION NO. GR-2413

OWNER: Linn Averill, attorney in fact for MAILING ADDRESS: Corvallis,
Martha J. Averill CITY AND STATE: Oregon
LOCATION OF WELL: Owner's No. #3

SW 1/4 NE 1/4 Sec. 36 T. 11 S., R. 5 W., W.M.

Bearing and distance from section or subdivision
corner 3300' N. 440' W. of NW corner Pleasant Robinette
DLC

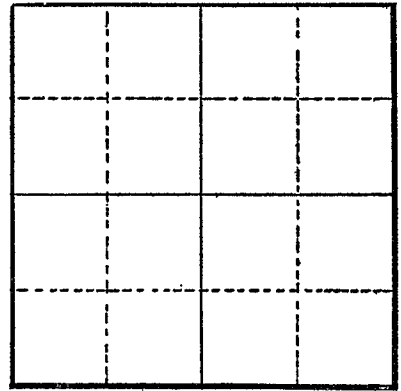

Section 35

Altitude at well _____

TYPE OF WELL: Drilled Date Constructed _____

Depth drilled 35 Depth cased 35

CASING RECORD:

10-inch

FINISH:

AQUIFERS:

Topsoil, sand, cemented sand and gravel

WATER LEVEL:

17-feet

PUMPING EQUIPMENT: Type Fairbanks Morse H.P. 7 1/2
Capacity 200 G.P.M.

WELL TESTS:

Drawdown 10 approx. ft. after _____ hours Pumping 300 G.P.M.
Drawdown _____ ft. after _____ hours _____ G.P.M.

USE OF WATER Irrigation Temp. _____ °F., 19 _____

SOURCE OF INFORMATION GR-2293

DRILLER or DIGGER _____

ADDITIONAL DATA:

Log X Water Level Measurements _____ Chemical Analysis _____ Aquifer Test _____

REMARKS:

| | | |
|--------------------------|-----|-----|
| Topsoil | 13' | 13' |
| Sand | 13' | 26' |
| Cemented sand and gravel | 2' | 28' |
| Open sand and gravel | 7' | 35' |