

STATE ENGINEER  
Salem, Oregon

# Well Record

*Bent*  
*4231*

STATE WELL NO. 11/5W-36G  
COUNTY BENTON  
APPLICATION NO. GR-2990

OWNER: Oregon State College


MAILING ADDRESS: Corvallis,

LOCATION OF WELL: Owner's No. \_\_\_\_\_

CITY AND STATE: Oregon

SW  $\frac{1}{4}$  NE  $\frac{1}{4}$  Sec. 36 T. 11 <sup>N.</sup> S., R. 5 <sup>E.</sup> W., W.M.

Bearing and distance from section or subdivision  
corner 3260' N. 150' E. of NW cor. Pleasant Robinette  
D.L.C. 71

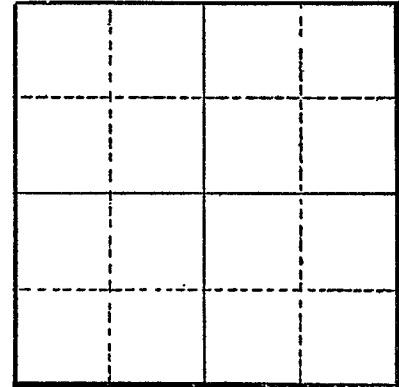

Section \_\_\_\_\_

Altitude at well \_\_\_\_\_

TYPE OF WELL: Drilled Date Constructed \_\_\_\_\_

Depth drilled 25' 5" Depth cased 24.5

CASING RECORD:

18-inch

FINISH:

AQUIFERS:

WATER LEVEL:

16.5-feet

PUMPING EQUIPMENT: Type Fairbanks Morse H.P. 10  
Capacity 165 G.P.M.

WELL TESTS:

Drawdown 1.5 ft. after \_\_\_\_\_ hours Pumping 165 G.P.M.  
Drawdown \_\_\_\_\_ ft. after \_\_\_\_\_ hours \_\_\_\_\_ G.P.M.

USE OF WATER Irrigation Temp. \_\_\_\_\_ °F., 19 \_\_\_\_\_

SOURCE OF INFORMATION GR-2799

DRILLER or DIGGER \_\_\_\_\_

ADDITIONAL DATA:

Log \_\_\_\_\_ Water Level Measurements \_\_\_\_\_ Chemical Analysis \_\_\_\_\_ Aquifer Test \_\_\_\_\_

REMARKS: