

STATE ENGINEER  
Salem, Oregon

# Well Record

*Bent*  
*4253*

STATE WELL NO. 11/5W-36M  
COUNTY Benton  
APPLICATION NO. GR-2988

OWNER: Oregon State College


MAILING ADDRESS: Corvallis, Oregon

LOCATION OF WELL: Owner's No. \_\_\_\_\_

CITY AND STATE: \_\_\_\_\_

NW  $\frac{1}{4}$  SW  $\frac{1}{4}$  Sec. 36 T. 11 S., R. 5 E. W., W.M.

Bearing and distance from section or subdivision corner \_\_\_\_\_

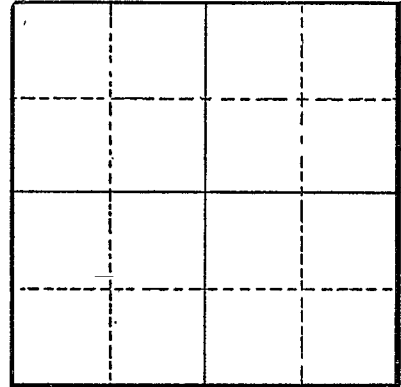

Section 36

Altitude at well \_\_\_\_\_

TYPE OF WELL: Drilled Date Constructed 1955

Depth drilled 31 Depth cased 31

### CASING RECORD:

Open pit 0 to 6 feet  
8 inch diameter standard steel pipe 6 to 22 feet  
perforated steel from 22 to 31 feet

### FINISH:

Unknown

### AQUIFERS:

### WATER LEVEL:

17 feet

PUMPING EQUIPMENT: Type Peerless 20 HP 3 phase H.P. \_\_\_\_\_  
Capacity 350 @ 155 TDH G.P.M.

### WELL TESTS:

Drawdown 5 ft. after \_\_\_\_\_ hours 560 G.P.M.  
Drawdown 3 ft. after \_\_\_\_\_ hours 300 G.P.M.

USE OF WATER Irrigation Temp. \_\_\_\_\_ °F., 19 \_\_\_\_\_

SOURCE OF INFORMATION GR-2988

DRILLER or DIGGER \_\_\_\_\_

### ADDITIONAL DATA:

Log \_\_\_\_\_ Water Level Measurements \_\_\_\_\_ Chemical Analysis \_\_\_\_\_ Aquifer Test \_\_\_\_\_

### REMARKS:

