

STATE ENGINEER
Salem, Oregon

BENT 4234
Well Record

Bent
4234

STATE WELL NO. 11/5W-36M
COUNTY Benton
APPLICATION NO. CR-2996

OWNER: Oregon State College MAILING ADDRESS: Corvallis, Oregon


LOCATION OF WELL: Owner's No. #1 CITY AND STATE: _____

NW $\frac{1}{4}$ SW $\frac{1}{4}$ Sec. 36 T. 11 S. R. 5 W., W.M.

Bearing and distance from section or subdivision

corner 2100' W. 1440' N. of N.W. Cor. Pleasant Robinette

D.L.C.

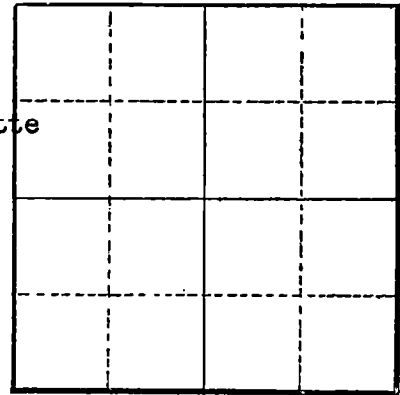

Section _____

Altitude at well _____

TYPE OF WELL: drilled Date Constructed _____

Depth drilled 41 Depth cased 41

CASING RECORD:

10-inch
10-inch

FINISH:

AQUIFERS:

Soil, clay, gravel and shale

WATER LEVEL:

15-feet

PUMPING EQUIPMENT: Type Gould Centrifugal H.P. 7 $\frac{1}{2}$

Capacity 140 G.P.M.

WELL TESTS:

Drawdown 8 ft. after _____ hours Pumping 400 G.P.M.

Drawdown 6.5 ft. after _____ hours Pumping 345 G.P.M.
3.5 Pumping 160

USE OF WATER Irrigation Temp. _____ °F. _____, 19

SOURCE OF INFORMATION GR-2805

DRILLER or DIGGER Studebaker Bros., Salem, Oregon

ADDITIONAL DATA:

Log Water Level Measurements _____ Chemical Analysis _____ Aquifer Test _____

REMARKS:

Soil	4	4
Clay	10	14
Cement Gravel	8	22
Fairly Loose Gravel	3	27
Very loose Gravel	5	32
Shale	9	41


This is our ~~BENT 4234~~ well.

Well 11/5W-26M

BY W. J. C. DATE _____
 CHD. BY _____ DATE _____
Apr 2, 1951
4/2/51

SUBJECT Plant 11/5W-26M - Botany
Well 11/5W-26M

SHEET NO. 1 OF 2
 JOB NO. _____

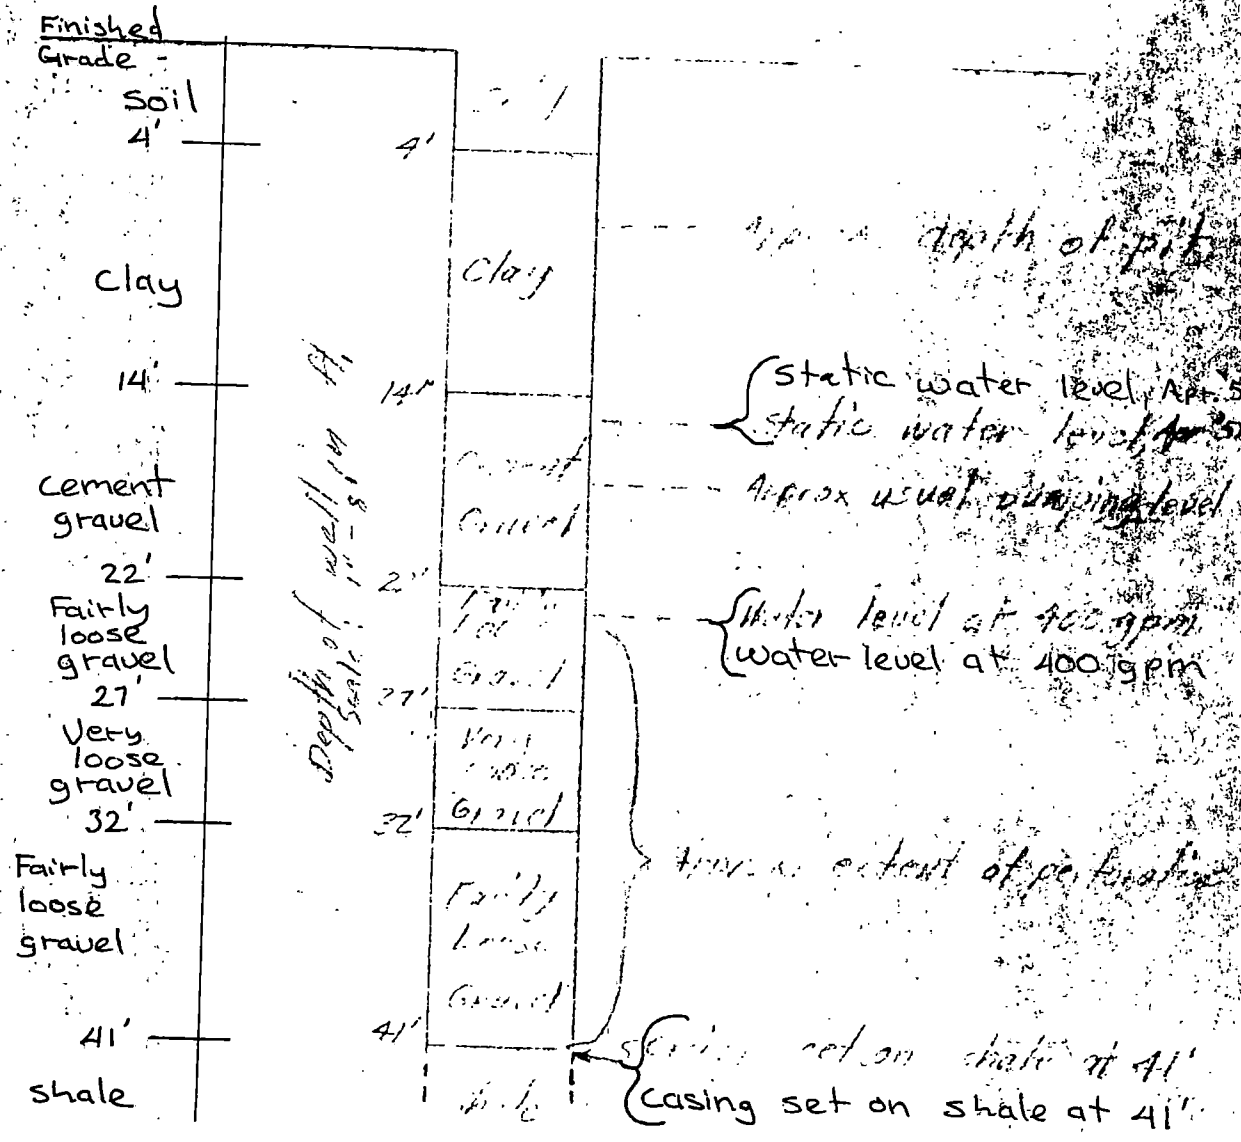

* This page correlated with BENT 4234 by OWRD staff.