

Bent
4663

OWNER: Chester Roche


MAILING ADDRESS: Rt. 1, Box 425,

LOCATION OF WELL: Owner's No. #1

CITY AND STATE: Corvallis, Oregon

SE 1/4 NE 1/4 Sec. 2 T. 11&12 N. S. R. 5 W., W.M.
1,2,35,36

Bearing and distance from section or subdivision corner N. 31° 30' E. 2178' to reference point, said point being 7.73 chains E. 3.0 chains N.

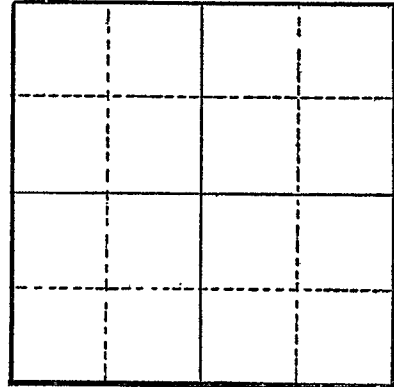

Section

Altitude at well

TYPE OF WELL: Drilled Date Constructed 1939

Depth drilled 30 Depth cased 30

CASING RECORD:

10-inch

FINISH:

AQUIFERS:

WATER LEVEL:

12-feet

PUMPING EQUIPMENT: Type Fairbanks Morse Centrifugal H.P. 30
Capacity 800 G.P.M.

WELL TESTS:

Drawdown 1 ft. after hours Pumping 800 G.P.M.
Drawdown ft. after hours G.P.M.

USE OF WATER Irrigation Temp. °F., 19

SOURCE OF INFORMATION GR-2285

DRILLER or DIGGER Art Slopner, (Deceased)

ADDITIONAL DATA:

Log Water Level Measurements Chemical Analysis Aquifer Test

REMARKS: