


OWNER: Chester Roche
MAILING ADDRESS: Rt. 1, Box 425,

LOCATION OF WELL: Owner's No. CITY AND STATE: Corvallis, Oregon

NE 1/4 NE 1/4 Sec. 2 T. 11&12 S., R. 5 W., W.M.
1,2,35,36

Bearing and distance from section or subdivision
corner N. 61° 15' E. 1125' to reference point, said
point located 7.73 chains E. and 3.0 chains N. from
common corner of said well.

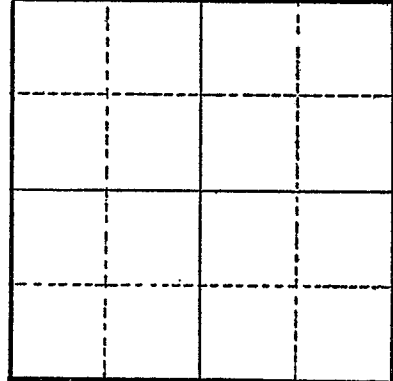

Section

Altitude at well

TYPE OF WELL: Drilled Date Constructed 1939

Depth drilled 30 Depth cased 30

CASING RECORD:

10-inch

FINISH:

Slotted, size and number unknown from 20' to 30'

AQUIFERS:

WATER LEVEL:

12-feet

PUMPING EQUIPMENT: Type Fairbanks Morse Centrifugal H.P. 30
Capacity 400 G.P.M.

WELL TESTS:

Drawdown 3 ft. after hours Pumping 400 G.P.M.
Drawdown ft. after hours G.P.M.

USE OF WATER Irrigation Temp. °F., 19

SOURCE OF INFORMATION GR-2286

DRILLER or DIGGER Art Sloper, (Deceased.)

ADDITIONAL DATA:

Log Water Level Measurements Chemical Analysis Aquifer Test

REMARKS: