

Well Record

Bent STATE WELL NO. 12/LW-6K
4675 COUNTY Benton
APPLICATION NO. GR-2993

OWNER: Oregon State College

MAILING ADDRESS: Corvallis, Oregon


LOCATION OF WELL: Owner's No. #2

CITY AND STATE: _____

NW 1/4 SE 1/4 Sec. 6 T. 12 ~~N~~ S., R. 4 ~~E~~ W., W.M.

Bearing and distance from section or subdivision

corner 1537' W. 1815' S. of James Robinette
D.L.C. 52

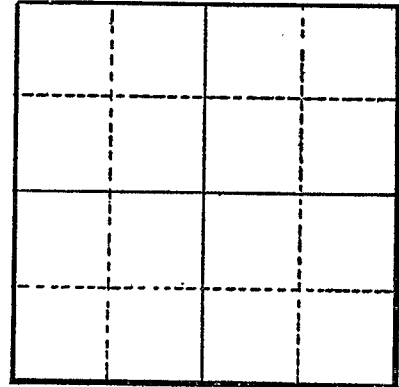

Section _____

Altitude at well _____

TYPE OF WELL: drilled Date Constructed _____

Depth drilled 31 Depth cased 31+

CASING RECORD:

10-inch

FINISH:

AQUIFERS:

WATER LEVEL:

17-feet

PUMPING EQUIPMENT: Type Pacific Centrifugal H.P. 7.5
Capacity 180 G.P.M.

WELL TESTS:

Drawdown _____ ft. after _____ hours _____ G.P.M.

Drawdown _____ ft. after _____ hours _____ G.P.M.

USE OF WATER Irrigation Temp. _____ °F. _____, 19 _____

SOURCE OF INFORMATION GR-2802

DRILLER or DIGGER _____

ADDITIONAL DATA:

Log _____ Water Level Measurements _____ Chemical Analysis _____ Aquifer Test _____

REMARKS: