

STATE ENGINEER
Salem, Oregon

Well Record

STATE WELL NO. 12/LW-6K
COUNTY Benton
APPLICATION NO. GR-2994

467b

OWNER: Oregon State College


MAILING ADDRESS: Corvallis, Oregon

LOCATION OF WELL: Owner's No. #3

CITY AND STATE:

NW 1/4 SE 1/4 Sec. 6 T. 12 S., R. 4 W., W.M.

Bearing and distance from section or subdivision corner 2960' W. 1638' S. of N.E. Corner James Robinette D.L.C. 52

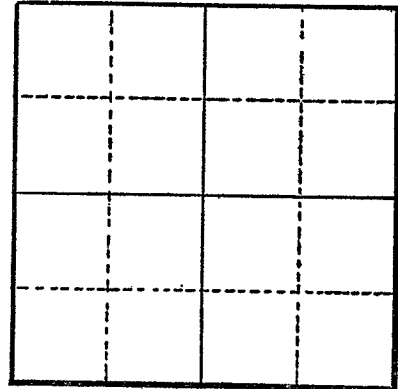

Section

Altitude at well

TYPE OF WELL: drilled Date Constructed

Depth drilled 35 Depth cased 35

CASING RECORD:

10-inch

FINISH:

AQUIFERS:

WATER LEVEL:

8-feet January 1958 - 17-feet July 1958

PUMPING EQUIPMENT: Type Fairbanks Morse Centrifugal H.P. 7 1/2
Capacity 180 G.P.M.

WELL TESTS:

Drawdown 17 ft. after hours pumping 175 G.P.M.
Drawdown 9 ft. after hours pumping 135 G.P.M.
Drawdown 3.5 ft. after hours pumping 67 G.P.M.

USE OF WATER irrigation Temp. °F., 19

SOURCE OF INFORMATION GR-2803

DRILLER or DIGGER

ADDITIONAL DATA:

Log Water Level Measurements Chemical Analysis Aquifer Test

REMARKS: