

STATE ENGINEER  
Salem, Oregon

# Well Record

STATE WELL NO. 12/4W-6K  
COUNTY Benton  
APPLICATION NO. GR-2995

4677

OWNER: Oregon State College


MAILING ADDRESS: Corvallis, Oregon

LOCATION OF WELL: Owner's No. \_\_\_\_\_

CITY AND STATE: \_\_\_\_\_

NW 1/4 SE 1/4 Sec. 6 T. 12 N. S., R. 4 E. W., W.M.

Bearing and distance from section or subdivision corner 1254' W. 2260' S. of James Robinette D.L.C. 52

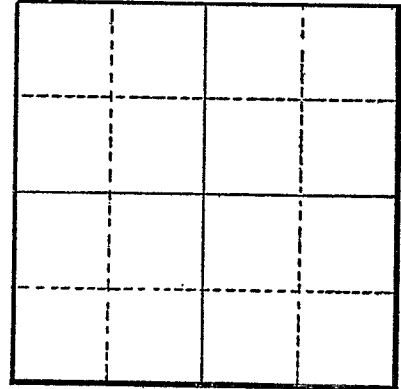

Section \_\_\_\_\_

Altitude at well \_\_\_\_\_

TYPE OF WELL: drilled Date Constructed \_\_\_\_\_

Depth drilled 35 Depth cased 35

CASING RECORD:

8-inch

FINISH:

AQUIFERS:

Soil, sand and gravel and clay

WATER LEVEL:

18.7-feet

PUMPING EQUIPMENT: Type Gould Centrifugal H.P. 15  
Capacity 360 G.P.M.

WELL TESTS:

Drawdown 5 ft. after \_\_\_\_\_ hours Pumping 350 G.P.M.  
Drawdown 2.5 ft. after \_\_\_\_\_ hours Pumping 210 G.P.M.

USE OF WATER Irrigation Temp. \_\_\_\_\_ °F., 19

SOURCE OF INFORMATION GR-2804

DRILLER or DIGGER Schafer

ADDITIONAL DATA:

Log  Water Level Measurements \_\_\_\_\_ Chemical Analysis \_\_\_\_\_ Aquifer Test \_\_\_\_\_

REMARKS:

Soil	2	2
Sand and gravel with a little clay	13	15
Sand and gravel with considerable clay	2	17
Coarse gravel with some sand	18	35