

4678

OWNER: Oregon State College


MAILING ADDRESS: Corvallis,

LOCATION OF WELL: Owner's No. _____

CITY AND STATE: Oregon

NW 1/4 SE 1/4 Sec. 6 T. 12 ^{N.} S., R. 4 ^{E.} W., W.M.

Bearing and distance from section or subdivision corner 2025' W. 1550' S. of James Robinette D.L.C. 52

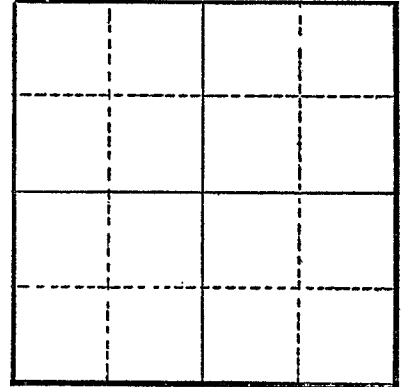

Section _____

Altitude at well _____

TYPE OF WELL: Drilled Date Constructed _____

Depth drilled 34 Depth cased 34

CASING RECORD:

10-inch

FINISH:

AQUIFERS:

WATER LEVEL:
16-feet

PUMPING EQUIPMENT: Type Gardner Denver Centrifugal H.P. 5
Capacity 120 at 130' G.P.M.

WELL TESTS:

Drawdown _____ ft. after _____ hours _____ G.P.M.

Drawdown _____ ft. after _____ hours _____ G.P.M.

USE OF WATER Irrigation Temp. _____ °F., 19 _____

SOURCE OF INFORMATION GR-2801

DRILLER or DIGGER _____

ADDITIONAL DATA:

Log _____ Water Level Measurements _____ Chemical Analysis _____ Aquifer Test _____

REMARKS: