

OWNER: *Therl F. Neville*


MAILING ADDRESS: *Rt. 4, Box 364-A*

LOCATION OF WELL: Owner's No. *#1*

CITY AND STATE: *Corvallis, Oregon*

SW 1/4 *NW* 1/4 Sec. *18* T. *12* N. S., R. *4* E. W., W.M.

Bearing and distance from section or subdivision corner *2431.09'S and 528.42' E.*

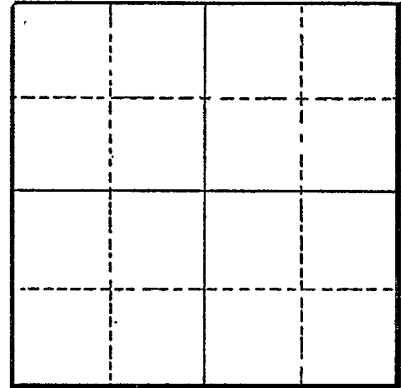

Section

Altitude at well

TYPE OF WELL: *Drilled* Date Constructed *1953*

Depth drilled *31* Depth cased *31*

CASING RECORD:

12-Inch

FINISH:

Perforations from 0 to 7

AQUIFERS:

Gravel and loam

WATER LEVEL:

20-Feet

PUMPING EQUIPMENT: Type *Centrifugal* H.P. *50*
Capacity *800* G.P.M.

WELL TESTS:
Drawdown *3' 6"* ft. after _____ hours *Pumping 800* G.P.M.
Drawdown _____ ft. after _____ hours _____ G.P.M.

USE OF WATER *Irrigation* Temp. _____ °F. _____, 19_____

SOURCE OF INFORMATION *GR-2085*

DRILLER or DIGGER _____

ADDITIONAL DATA:

Log Water Level Measurements _____ Chemical Analysis _____ Aquifer Test _____

REMARKS:

*0 - 16 feet Loam and Gravel
16- 31 feet gravel coarse*