

OWNER: Elmer C. Hathaway


MAILING ADDRESS: Route 3, Box 406

LOCATION OF WELL: Owner's No. Well #1

CITY AND STATE: Corvallis, Oregon

SW 1/4 SW 1/4 Sec. 19 T. 12 N. S., R. 4 W., W.M.

Bearing and distance from section or subdivision corner 792' N. and 862' E.

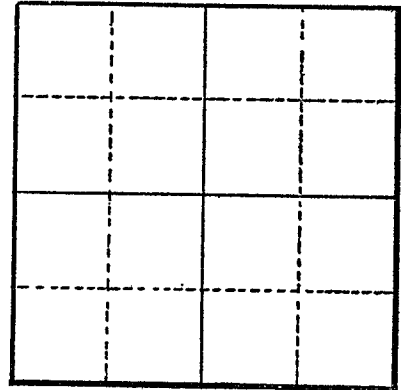

Section

Altitude at well

TYPE OF WELL: drilled Date Constructed 1948

Depth drilled 20' Depth cased 20'

CASING RECORD:

5"

FINISH:

AQUIFERS:

river bottom, gravel

WATER LEVEL:

12'

PUMPING EQUIPMENT: Type Weinman Pump Capacity G.P.M.

H.P. 5

WELL TESTS:

Drawdown 2 ft. after hours pumping 125+ G.P.M.

Drawdown ft. after hours G.P.M.

USE OF WATER Irrigation Temp. °F., 19

SOURCE OF INFORMATION GR-3193

DRILLER or DIGGER Frank Skillings Philomath, Oregon

ADDITIONAL DATA:

Log Water Level Measurements Chemical Analysis Aquifer Test

REMARKS:

river bottom
gravel

18
2