

STATE ENGINEER
Salem, Oregon

Well Record

Bent
4693
STATE WELL NO. 12/LW-19P
COUNTY Benton
APPLICATION NO. GR-3451

OWNER: Elmer C. Hathaway


MAILING ADDRESS: Route 3, Box 406

LOCATION OF WELL: Owner's No. 2

CITY AND STATE: Corvallis, Oregon

SE 1/4 SW 1/4 Sec. 19 T. 12 ~~N.~~ S., R. 4 ~~E.~~ W., W.M.

Bearing and distance from section or subdivision corner 792' N. and 1110' E.

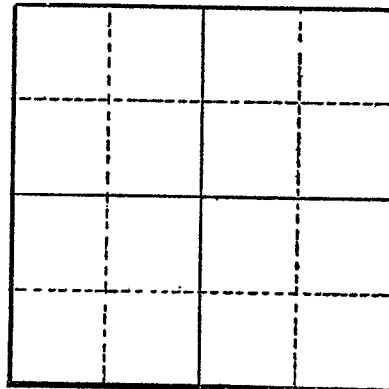

Section

Altitude at well

TYPE OF WELL: drilled Date Constructed 1954

Depth drilled 21' Depth cased 21'

CASING RECORD:

6"

FINISH:

AQUIFERS:

gravel

WATER LEVEL:

12'

PUMPING EQUIPMENT: Type Fairbanks Morse H.P. 5
Capacity G.P.M.

WELL TESTS:

Drawdown 2 ft. after hours pumping 100+ G.P.M.

Drawdown ft. after hours G.P.M.

USE OF WATER Irrigation Temp. °F., 19

SOURCE OF INFORMATION GR-3192

DRILLER or DIGGER

ADDITIONAL DATA:

Log ^x Water Level Measurements Chemical Analysis Aquifer Test

REMARKS:

gravel

21