

Bent
4710

OWNER: Earl B. Hathaway


MAILING ADDRESS: Rt. 3, B

LOCATION OF WELL: Owner's No. #2

CITY AND STATE: Corvallis, Oregon

SW 1/4 NE 1/4 Sec. 30 T. 12 N. S., R. 4 W., W.M.

Bearing and distance from section or subdivision corner 96.71' N. & 3149.75' E.

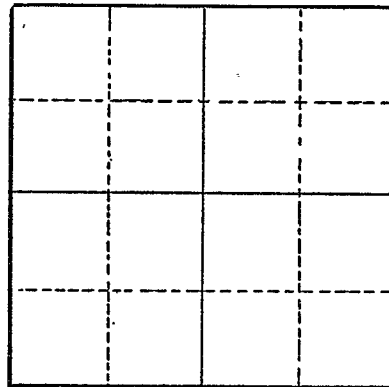

Section

Altitude at well

TYPE OF WELL: Driven Date Constructed 1950

Depth drilled 25 Depth cased 25

CASING RECORD:

2 1/2-inch

FINISH:

AQUIFERS:

Soil and gravel

WATER LEVEL:

12-feet

PUMPING EQUIPMENT: Type Fairbanks Morse and Allis Chalmers H.P. 30
Capacity 450 G.P.M.

WELL TESTS:

Drawdown ? ft. after hours Pumping 200? G.P.M.
Drawdown ft. after hours G.P.M.

USE OF WATER Irrigation Temp. °F. 19

SOURCE OF INFORMATION GR-2496

DRILLER or DIGGER

ADDITIONAL DATA:

Log X Water Level Measurements Chemical Analysis Aquifer Test

REMARKS:

Soil 12
Gravel 12