

RECEIVED
JUL 22 1960

File Original and
First Copy with the
STATE ENGINEER,
SALEM, OREGON

Bent
4734

WATER WELL REPORT

STATE OF OREGON

G1804

State Well No. 12/SW-2N


State Permit No.

(1) OWNER:

Name F S NEVILLE
Address 1190 So 3rd
Corvallis, Oregon

(2) LOCATION OF WELL:

County Benton Owner's number, if any--
1/4 1/4 Section 2 T. 12-S R. 5-W W.M.
Bearing and distance from section or subdivision corner

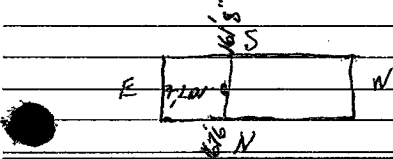

(3) TYPE OF WORK (check):

New Well Deepening Reconditioning Abandon
If abandonment, describe material and procedure in Item 11.

(4) PROPOSED USE (check):

Domestic Industrial Municipal
Irrigation Test Well Other

(5) TYPE OF WELL:

Rotary Driven
Cable Jetted
Dug Bored

(6) CASING INSTALLED:

Threaded Welded

6" Diam. from 0 ft. to 4.1 ft. Gage 250
" Diam. from ft. to ft. Gage
" Diam. from ft. to ft. Gage

(7) PERFORATIONS:

Perforated? Yes No

Type of perforator used Cut
SIZE of perforations 1/8 in. by 10 in.
10 perforations from 3.6 ft. to 4.1 ft.
perforations from ft. to ft.
perforations from ft. to ft.
perforations from ft. to ft.
perforations from ft. to ft.

(8) SCREENS:

Well screen installed Yes No

Manufacturer's Name
Type Model No.
Diam. Slot size Set from ft. to ft.
Diam. Slot size Set from ft. to ft.

(9) CONSTRUCTION:

Was well gravel packed? Yes No Size of gravel:
Gravel placed from ft. to ft.
Was a surface seal provided? Yes No To what depth? ft.
Material used in seal--
Did any strata contain unusable water? Yes No
Type of water? Depth of strata
Method of sealing strata off

(10) WATER LEVELS:

Static level 14 ft. below land surface Date July 5-60
Artesian pressure lbs. per square inch Date

Log Accepted by:

[Signed] E. S. Neville Date July 7, 1960
(Owner)

(11) WELL TESTS:

Drawdown is amount water level is lowered below static level

Was a pump test made? Yes No If yes, by whom? -
Yield: gal./min. with ft. drawdown after hrs.
" " " "
" " " "
Bailer test 50 gal./min. with 7 ft. drawdown after 1 hrs.
Artesian flow g.p.m. Date
Temperature of water Was a chemical analysis made? Yes No

(12) WELL LOG:

Diameter of well 6 inches.

Depth drilled 5-6 ft. Depth of completed well 5-0 ft.

Formation: Describe by color, character, size of material and structure, and show thickness of aquifers and the kind and nature of the material in each stratum penetrated, with at least one entry for each change of formation.

MATERIAL	FROM	TO
TAP SOIL	0	4
BROWN CLAY + SAND	4	20
CEMENT GRAVEL	20	38
Blue CLAY	38	38
BROWN SAND & CLAY	48	50
Blue CLAY	50	5-6

Work started July 2 1960 Completed July 5 1960

(13) PUMP:

Manufacturer's Name
Type: H.P.

Well Driller's Statement:

This well was drilled under my jurisdiction and this report is true to the best of my knowledge and belief.

NAME Crispin Well Drilling
(Person, firm, or corporation) (Type or print)

Address R# 2 Box 17 ALBANY

Driller's well number 26

[Signed] Louis Crispin
(Well Driller)

License No. 280 Date July 6, 1960