

STATE ENGINEER
Salem, Oregon

Well Record

Bent
4735 STATE WELL NO. 12/5W-2N(1)
COUNTY Benton
APPLICATION NO. GR-657

OWNER: Owen H. Moore MAILING ADDRESS: 270 Allen Lane

LOCATION OF WELL: Owner's No. 1 CITY AND STATE: Corvallis, Oregon

SW $\frac{1}{4}$ SW $\frac{1}{4}$ Sec. 2 T. 12 S., R. 5 W., W.M.


Bearing and distance from section or subdivision corner 130' East and 300 feet North from the SW corner of Section 2, T. 12 S., R. 5 W.

Altitude at well 225' Interpolated

TYPE OF WELL: Drilled Date Constructed 1939

Depth drilled 38 Depth cased 38

CASING RECORD:
5"

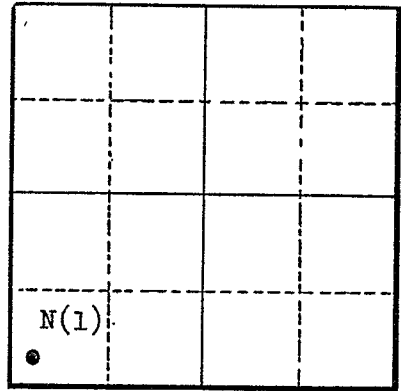

Section 2

FINISH:

AQUIFERS:

WATER LEVEL:
24'

PUMPING EQUIPMENT: Type F. M. Centrifugal 1 1/2 x 1 jet boosted H.P. 1
Capacity 30 G.P.M.

WELL TESTS:
Drawdown 4 ft. after _____ hours 30 G.P.M.
Drawdown _____ ft. after _____ hours _____ G.P.M.

USE OF WATER Domestic & irrigation 2.0 A Temp. _____ °F., 19

SOURCE OF INFORMATION GR-657

DRILLER or DIGGER _____

ADDITIONAL DATA:
Log _____ Water Level Measurements _____ Chemical Analysis _____ Aquifer Test _____

REMARKS: