

STATE ENGINEER  
Salem, Oregon

Well Record Bent STATE WELL NO. 12/5W-2R  
4738 COUNTY Benton  
APPLICATION NO. CR-3531

OWNER: Crystal Lake Cemetery


MAILING ADDRESS: Masonic Temple

LOCATION OF WELL: Owner's No.

CITY AND STATE: Corvallis, Oregon

SE 1/4 SE 1/4 Sec. 2 T. 12 S., R. 5 W., W.M.

Bearing and distance from section or subdivision  
corner 1 ch. N. and 0.5 ch. W. of SE corner of  
J.C. Avery D.L.C. #41

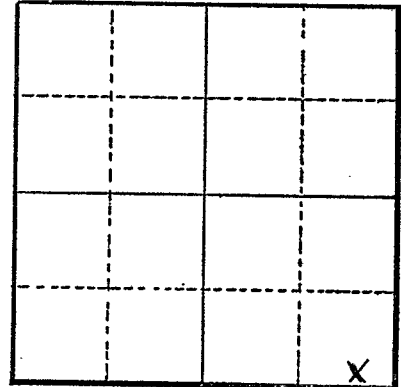

Altitude at well

TYPE OF WELL: Dug Date Constructed Nov. 1953

Depth drilled 20 ft. Depth cased

Section 2

CASING RECORD:

FINISH:

Cribbed with 4 x 4 fir, cracks covered with 1 inch fir boards from bottom to about 4 feet from top then concrete blocks to 3 feet above ground level.

AQUIFERS:

Gravel

WATER LEVEL:

about 8 feet below surface

PUMPING EQUIPMENT: Type Pomona, Fairbanks Moris H.P. 7 1/2  
Capacity 150 G.P.M. Vertical Hallow Shafts

WELL TESTS:

Drawdown 80 ft. after hours 1000 G.P.M.

Drawdown ft. after hours G.P.M.

USE OF WATER Irrigation Temp. °F. 19

SOURCE OF INFORMATION Well Registration Statement

DRILLER or DIGGER

ADDITIONAL DATA:

Log X Water Level Measurements Chemical Analysis Aquifer Test

REMARKS:

