

STATE ENGINEER
Salem, Oregon


Well Record ^{Bent}
4739
STATE WELL NO. 12/5W-2B(1)
COUNTY Benton
APPLICATION NO. GR-556

OWNER: Herbert Brown
MAILING ADDRESS: Route 4, Box 352

LOCATION OF WELL: Owner's No. _____
CITY AND STATE: Corvallis, Oregon

NW ¼ NE ¼ Sec. 2 T. 12 N. S. R. 5 W., W.M.

Bearing and distance from section or subdivision
corner S. 39° 52' W. 1875.4' from government
survey point on Township line 12 S. 4 & 5 W.

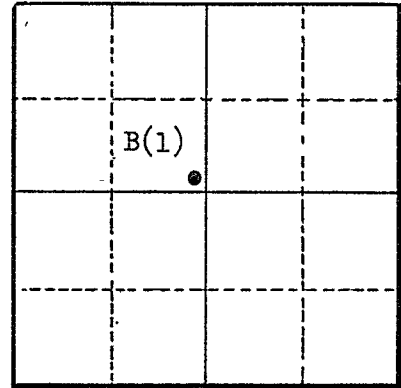

Section 12

Altitude at well 218

TYPE OF WELL: Drilled Date Constructed April '53

Depth drilled 30 Depth cased 30

CASING RECORD:
12"

FINISH:

AQUIFERS:

WATER LEVEL:

11"

PUMPING EQUIPMENT: Type Morse centrifugal H.P. 25
Capacity 550 G.P.M.

WELL TESTS:

Drawdown 19 ft. after _____ hours 800 G.P.M.

Drawdown _____ ft. after _____ hours _____ G.P.M.

USE OF WATER Irrigation - 100 Ac. Temp. _____ °F., 19

SOURCE OF INFORMATION GR-556

DRILLER or DIGGER _____

ADDITIONAL DATA:

Log _____ Water Level Measurements _____ Chemical Analysis _____ Aquifer Test _____

REMARKS:

Silt 0 - 5'
Sand 5 - 16'
Gravel 16 - 30'