

STATE ENGINEER
Salem, Oregon


Well Record

*Bent
4771*

STATE WELL NO. 12/5W-3M
COUNTY Benton
APPLICATION NO. GR-3687

OWNER: Herbert E. Childs MAILING ADDRESS: 1515 Brook Lane
CITY AND STATE: Corvallis, Oregon

LOCATION OF WELL: Owner's No. _____
N. E.
NW 1/4 SW 1/4 Sec. 3 T. 12 S., R. 5 W., W.M.
Bearing and distance from section or subdivision
corner 7.018 ch. plus approx. 90' N. 6° 10' W.
and approx. 110' E. of SW cor. Joseph C. Avery
DLC # 41

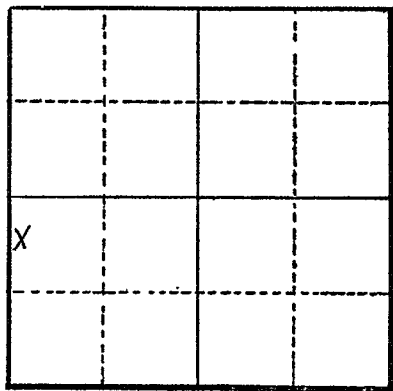

Section 3

Altitude at well _____
TYPE OF WELL: Drilled Date Constructed 1923
Depth drilled approx. 25' Depth cased approx. 25'

CASING RECORD:

3/4" pipe in 1/4" casing set to approx. 25 feet

FINISH:

AQUIFERS:

WATER LEVEL:

approx. 12 feet below surface

PUMPING EQUIPMENT: Type F and W rotary H.P. 1/4
Capacity 3 G.P.M.

WELL TESTS:

Drawdown _____ ft. after _____ hours 3 G.P.M.
Drawdown _____ ft. after _____ hours _____ G.P.M.

USE OF WATER Irrigation Temp. _____ °F., 19

SOURCE OF INFORMATION Well Registration Statement

DRILLER or DIGGER _____

ADDITIONAL DATA:
Log X Water Level Measurements _____ Chemical Analysis _____ Aquifer Test _____

REMARKS:

Log: Soil at the surface is probably Amith type; probably at least 10 - 12 feet thick; strata underneath, if different, are unknown.

Well is situated in basement of dwelling.

3379