

STATE ENGINEER
Salem, Oregon

Well Record

Bent
4815

STATE WELL NO. 12/5W-4E
COUNTY Benton
APPLICATION NO. GR-3661

OWNER: Edgar A. DeMeules


MAILING ADDRESS: 4190 West Hills Road

LOCATION OF WELL: Owner's No. _____

CITY AND STATE: Corvallis, Oregon

SW $\frac{1}{4}$ NW $\frac{1}{4}$ Sec. 4 T. 12 S., R. 5 W., W.M.

Bearing and distance from section or subdivision corner 2109.1' E. 4048' N. to NE cor. A.G. Hovey
D.L.C. # 43

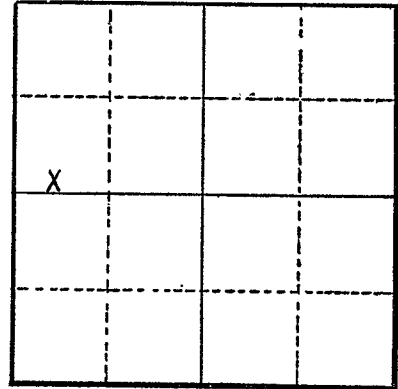

Section 4

Altitude at well _____

TYPE OF WELL: Drilled Date Constructed 1947

Depth drilled 65 ft. Depth cased 65 ft.

CASING RECORD:

4 inch casing set to 65 feet

FINISH:

Slotted from 55 to 65 feet

AQUIFERS:

WATER LEVEL:

PUMPING EQUIPMENT: Type Fairbanks Morse H.P. 1
Capacity 600 G.P.M.

WELL TESTS:

Drawdown 50 ft. after _____ hours 10 G.P.M.
Drawdown _____ ft. after _____ hours _____ G.P.M.

USE OF WATER Irrigation Temp. _____ °F. _____, 19____

SOURCE OF INFORMATION Well Registration Statement

DRILLER or DIGGER C. L. Skillings

ADDITIONAL DATA:

Log _____ Water Level Measurements _____ Chemical Analysis _____ Aquifer Test _____

REMARKS:

3357