

STATE ENGINEER  
Salem, Oregon

# Well Record

*Cent*  
*4316* STATE WELL NO. 12/5W-4 H  
COUNTY BENTON  
APPLICATION NO. GR-2461

OWNER: Frank E. Fox


MAILING ADDRESS: Rt 2 Box 362

LOCATION OF WELL: Owner's No. \_\_\_\_\_

CITY AND STATE: Corvallis, Oregon

SE 1/4 NE 1/4 Sec. 4 T. 12 S., R. 5 W., W.M.

Bearing and distance from section or subdivision corner 850' W & 270' N from E 1/4 cor. Sec. 4

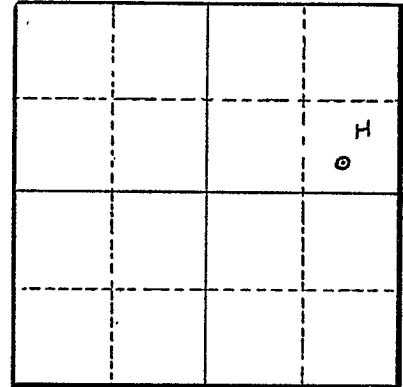

Section 4

Altitude at well \_\_\_\_\_

TYPE OF WELL: Drilled Date Constructed 1950

Depth drilled 57' Depth cased 23'

CASING RECORD:

6-inch

FINISH:

AQUIFERS:

soapstone & shale

WATER LEVEL:

PUMPING EQUIPMENT: Type Fairbanks Morse H.P. 1

Capacity 40 G.P.M.

WELL TESTS:

Drawdown \_\_\_\_\_ ft. after \_\_\_\_\_ hours 45 G.P.M.

Drawdown \_\_\_\_\_ ft. after \_\_\_\_\_ hours \_\_\_\_\_ G.P.M.

USE OF WATER Irrigation Temp. \_\_\_\_\_ °F. \_\_\_\_\_, 19\_\_\_\_\_

SOURCE OF INFORMATION GR-3923

DRILLER or DIGGER Skillingn

ADDITIONAL DATA:

Log  Water Level Measurements \_\_\_\_\_ Chemical Analysis \_\_\_\_\_ Aquifer Test \_\_\_\_\_

REMARKS:

17' to soapstone and shale