

STATE ENGINEER  
Salem, Oregon

# Well Record

*Bent*  
*4818* STATE WELL NO. 12/5W-4H  
COUNTY Benton  
APPLICATION NO. GR-3133

OWNER: D. E. Bullis


MAILING ADDRESS: 3650 Philomath Road

LOCATION OF WELL: Owner's No. \_\_\_\_\_

CITY AND STATE: Corvallis, Oregon

SE 1/4 NE 1/4 Sec. 4 T. 12 S., R. 5 W., W.M.

Bearing and distance from section or subdivision corner 2360' E. and 210' N

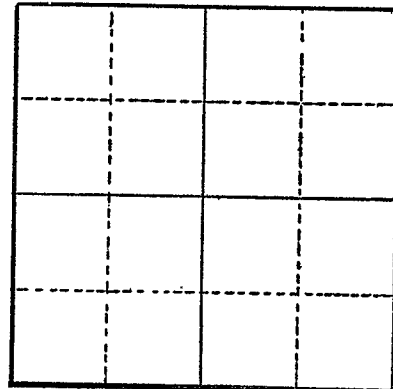

Section \_\_\_\_\_

Altitude at well \_\_\_\_\_

TYPE OF WELL: Drilled Date Constructed 1951

Depth drilled 55' Depth cased 17'

CASING RECORD:  
6"

FINISH: \_\_\_\_\_

AQUIFERS: \_\_\_\_\_

WATER LEVEL:

17'

PUMPING EQUIPMENT: Type Fairbanks Morse Jet H.P. 2  
Capacity 25 G.P.M.

WELL TESTS:

Drawdown \_\_\_\_\_ ft. after \_\_\_\_\_ hours pumping 40 G.P.M.

Drawdown \_\_\_\_\_ ft. after \_\_\_\_\_ hours \_\_\_\_\_ G.P.M.

USE OF WATER Irrigation Temp. \_\_\_\_\_ °F. \_\_\_\_\_, 19

SOURCE OF INFORMATION GR-2938

DRILLER or DIGGER Frank Skillings, Route 1, Corvallis, Oregon

ADDITIONAL DATA:

Log \_\_\_\_\_ Water Level Measurements \_\_\_\_\_ Chemical Analysis \_\_\_\_\_ Aquifer Test \_\_\_\_\_

REMARKS: \_\_\_\_\_