

STATE ENGINEER  
Salem, Oregon

# Well Record

*Bent*  
*4821* STATE WELL NO. 12/5W-4L  
COUNTY Benton  
APPLICATION NO. GR-4015

OWNER: Evelyn S. Folts


MAILING ADDRESS: 4030 West Hills Rd.

LOCATION OF WELL: Owner's No. \_\_\_\_\_

CITY AND STATE: Corvallis, Oregon

NE  $\frac{1}{4}$  SW  $\frac{1}{4}$  Sec. 4 T. 12 N. S., R. 5 E. W., W.M.

Bearing and distance from section or subdivision corner 9.22 chs. W. & 2.80 chs. S. of NE Cor. S. G. Hovey  
cl. 43

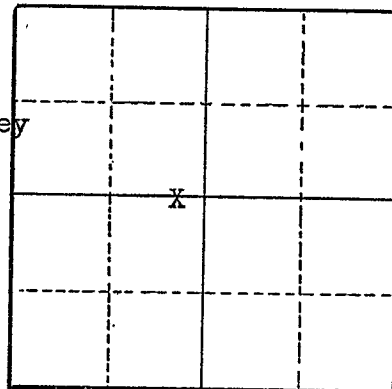

Section 4

Altitude at well \_\_\_\_\_

TYPE OF WELL: Drilled Date Constructed 5/48

Depth drilled 42 ft. Depth cased 42 ft.

### CASING RECORD:

5 inch casing set to 42 feet

### FINISH:

Slotted perforations

### AQUIFERS:

### WATER LEVEL:

24 feet below surface

PUMPING EQUIPMENT: Type Jacuzzi H.P.  $\frac{1}{2}$   
Capacity 6 G.P.M.

### WELL TESTS:

Drawdown 18 ft. after \_\_\_\_\_ hours 7 \_\_\_\_\_ G.P.M.  
Drawdown \_\_\_\_\_ ft. after \_\_\_\_\_ hours \_\_\_\_\_ G.P.M.

USE OF WATER Irrigation Temp. \_\_\_\_\_ °F. \_\_\_\_\_, 19\_\_\_\_

SOURCE OF INFORMATION Well Registration Statement Cert. # GR-3618

DRILLER or DIGGER \_\_\_\_\_

### ADDITIONAL DATA:

Log \_\_\_\_\_ Water Level Measurements \_\_\_\_\_ Chemical Analysis \_\_\_\_\_ Aquifer Test \_\_\_\_\_

### REMARKS: