

STATE ENGINEER  
Salem, Oregon

# Well Record

*Bent*  
*4827*

STATE WELL NO. 12/5-4<sup>N</sup>  
COUNTY Benton  
APPLICATION NO. GR-4134

OWNER: Harley & Frankie Libby

MAILING ADDRESS: 200 S. 42nd St.


LOCATION OF WELL: Owner's No. 2

CITY AND STATE: Corvallis, Oregon

SW  $\frac{1}{4}$  SW  $\frac{1}{4}$  Sec. 4 T. 12 S., R. 5 W., W.M.

Bearing and distance from section or subdivision

corner 760' N & 96' E of SW cor Sec 4

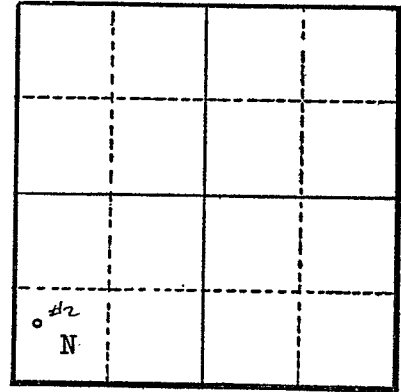

Section 4

Altitude at well 235'

TYPE OF WELL: Drilled Date Constructed July 1943

Depth drilled 100' Depth cased \_\_\_\_\_

CASING RECORD:

4"

FINISH:

7 per foot

AQUIFERS:

WATER LEVEL:

20'

PUMPING EQUIPMENT: Type Meyers Deep Well H.P. 1/2  
Capacity 20 G.P.M.

WELL TESTS:

Drawdown 6-8 ft. after \_\_\_\_\_ hours 125 G.P.M.

Drawdown \_\_\_\_\_ ft. after \_\_\_\_\_ hours \_\_\_\_\_ G.P.M.

USE OF WATER Domestic, commercial Temp. \_\_\_\_\_ °F. \_\_\_\_\_, 19\_\_\_\_

SOURCE OF INFORMATION GR-3990

DRILLER or DIGGER Throbal Knutson, Silverton, Oregon

ADDITIONAL DATA:

Log NA Water Level Measurements \_\_\_\_\_ Chemical Analysis \_\_\_\_\_ Aquifer Test \_\_\_\_\_

REMARKS: