

STATE ENGINEER
Salem, Oregon

Well Record


Bent STATE WELL NO. 12/5W-4P
COUNTY Benton
4829 APPLICATION NO. GR-3756

OWNER: Robert E. Reiman MAILING ADDRESS: 3901 Country Club Way

LOCATION OF WELL: Owner's No. _____ CITY AND STATE: Corvallis, Oregon

SE 1/4 SW 1/4 Sec. 4 T. 12 S., R. 5 W., W.M.

Bearing and distance from section or subdivision corner 40' N. & 132' W. of SE Cor. to A.G. Hovey
D.L.C. # 43

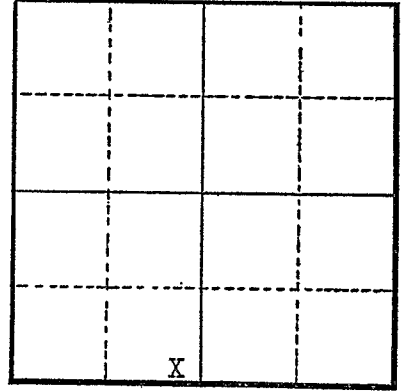

Altitude at well _____

TYPE OF WELL: Drilled Date Constructed prior to 1950

Depth drilled 46 feet Depth cased _____

Section _____

CASING RECORD:

FINISH:

AQUIFERS:

WATER LEVEL:

PUMPING EQUIPMENT: Type Homart Jet combination H.P. 2
Capacity _____ G.P.M.

WELL TESTS:
Drawdown _____ ft. after _____ hours _____ G.P.M.
Drawdown _____ ft. after _____ hours _____ G.P.M.

USE OF WATER Irrigation Temp. _____ °F. _____, 19_____

SOURCE OF INFORMATION Well Registration Statement

DRILLER or DIGGER _____

ADDITIONAL DATA:
Log _____ Water Level Measurements _____ Chemical Analysis _____ Aquifer Test _____

REMARKS:

3216