

STATE ENGINEER
Salem, Oregon

Well Record

STATE WELL NO. 12/5W-40
COUNTY BENTON
APPLICATION NO. GR-2453

OWNER: R. C. Schreiber

MAILING ADDRESS: 640 Country Club Way

LOCATION OF WELL: Owner's No. _____

CITY AND STATE: Corvallis, Oregon

SW $\frac{1}{4}$ SE $\frac{1}{4}$ Sec. 4 T. 12 S. R. 5 W., W.M.


Bearing and distance from section or subdivision

corner 3500' E. and 297' N.

Altitude at well _____

TYPE OF WELL: Drilled Date Constructed 1955

Depth drilled 104 Depth cased 45

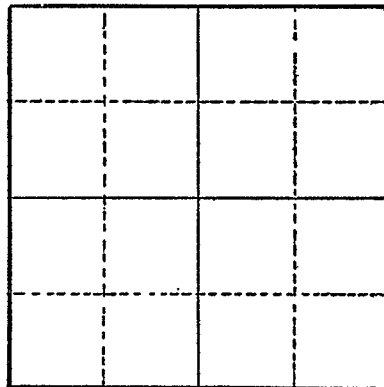

Section _____

CASING RECORD:

8-inch

FINISH:

AQUIFERS:

Soil, clay and shale

WATER LEVEL:

10-feet

PUMPING EQUIPMENT: Type Fairbanks Morse H.P. 2
Capacity 330 G.P.M.

WELL TESTS:

Drawdown 60 ft. after _____ hours Pumping 250 G.P.M.

Drawdown _____ ft. after _____ hours _____ G.P.M.

USE OF WATER Irrigation Temp. _____ °F. _____, 19_____

SOURCE OF INFORMATION GR-2324

DRILLER or DIGGER Howells, Philomath, Oregon

ADDITIONAL DATA:

Log X Water Level Measurements _____ Chemical Analysis _____ Aquifer Test _____

REMARKS:

Chehalis Soil 27

Blue Clay 10

Shale 47