


Bent
507

OWNER: Betty Lynd Thompson
MAILING ADDRESS: Corvallis,

LOCATION OF WELL: Owner's No. CITY AND STATE: Oregon

NW 1/4 NW 1/4 Sec. 8 T. 12 S., R. 5 W., W.M.

Bearing and distance from section or subdivision corner 990' S. 77° E.

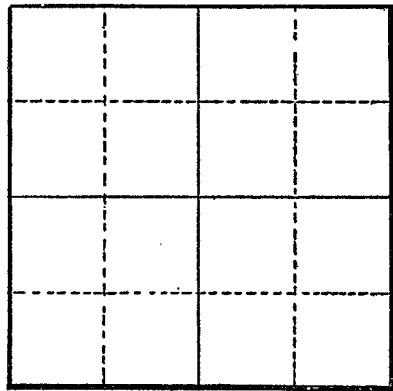

Section

Altitude at well

TYPE OF WELL: Drilled Date Constructed 1950

Depth drilled 90 Depth cased 50+

CASING RECORD:

8-inch

FINISH:

AQUIFERS:

WATER LEVEL:

60-feet

PUMPING EQUIPMENT: Type Crane jet model 2320 H.P. 2

Capacity 25 G.P.M.

WELL TESTS: Drawdown 10 ft. after hours Pumping 10 G.P.M.

Drawdown ft. after hours G.P.M.

USE OF WATER Irrigation Temp. °F., 19

SOURCE OF INFORMATION GR-2280

DRILLER or DIGGER Frank Skillings, Route 1, Corvallis, Oregon

ADDITIONAL DATA: Log Water Level Measurements Chemical Analysis Aquifer Test

REMARKS: