

STATE ENGINEER
Salem, Oregon

Well Record

Bent
5061 STATE WELL NO. 12/5W-9
COUNTY BENTON
APPLICATION NO. GR-2901

OWNER: Robert L. Skelton


MAILING ADDRESS: 3940 Nash Road

LOCATION OF WELL: Owner's No. _____

CITY AND STATE: Corvallis, Oregon

_____ $\frac{1}{4}$ _____ $\frac{1}{4}$ Sec. 9 T. 12 ^{N.} S., R. 5 ^{E.} W., W.M.

Bearing and distance from section or subdivision corner S. 80° 58' W. 2837.77' and S. 0° 07' E. 1014.21' from the SW corner of the James A. Bennett DLC #45.

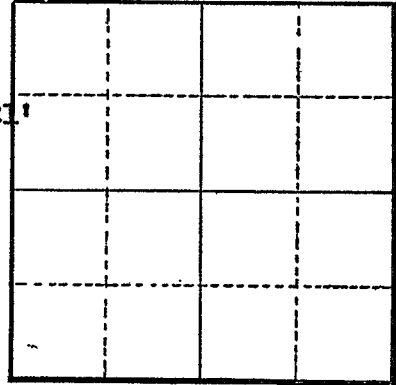

Section _____

Altitude at well _____

TYPE OF WELL: drilled Date Constructed 1953

Depth drilled 80 Depth cased 70

CASING RECORD:

8-inch

FINISH:

AQUIFERS:

WATER LEVEL:
15-feet

PUMPING EQUIPMENT: Type Dorward E.D. Jet Pump H.P. 3
Capacity 50 G.P.M.

WELL TESTS:
Drawdown 40 ft. after _____ hours Pumping 40 G.P.M.
Drawdown _____ ft. after _____ hours _____ G.P.M.

USE OF WATER Irrigation Temp. _____ °F., 19 _____

SOURCE OF INFORMATION GR-2730

DRILLER or DIGGER Bill Howell, Rt. 2, Corvallis, Oregon

ADDITIONAL DATA:

Log _____ Water Level Measurements _____ Chemical Analysis _____ Aquifer Test _____

REMARKS: