

BENT 5102

STATE ENGINEER
Salem, Oregon

Well Record

Bent
5102

STATE WELL NO. 12/5W-10D
COUNTY Benton
APPLICATION NO. GR-3195

OWNER: Fred W. Furst


MAILING ADDRESS: 315 Whiteside Drive

LOCATION OF WELL: Owner's No.

CITY AND STATE: Oregon

NW 1/4 NW 1/4 Sec. 10 T. 12 N. S, R. 5 W., W.M.

Bearing and distance from section or subdivision corner 30 feet South and 3 feet West of NE Corner, Lot 7, Block 5, of Country Club Hgts and Long Hill Hgts adjacent to Corvallis

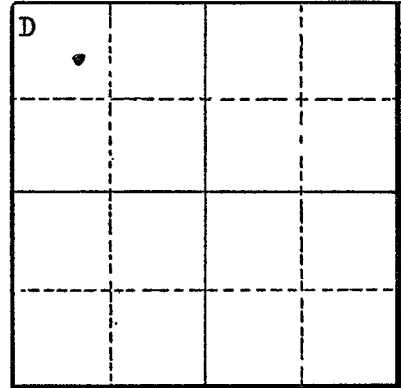

Altitude at well 265 feet

Section 10

TYPE OF WELL: Drilled Date Constructed July 1947

Depth drilled 105 feet Depth cased 28 feet

CASING RECORD:

6-inch casing set from 0 to 28 feet

FINISH:

AQUIFERS:

WATER LEVEL:

50 feet

PUMPING EQUIPMENT: Type Berkley Combination Jet H.P.
Capacity G.P.M.

WELL TESTS:

Drawdown 50 ft. after 4 hours G.P.M.
Drawdown 70 ft. after 2 to 3 hours G.P.M.

USE OF WATER Irrigation Temp. °F., 19

SOURCE OF INFORMATION GR-4057

DRILLER or DIGGER Frank L. Skillings

ADDITIONAL DATA:

Log (NA) Water Level Measurements Chemical Analysis Aquifer Test

REMARKS: