

STATE ENGINEER
Salem, Oregon


Well Record *Bent* *5175*

STATE WELL NO. 12/5W-12E
COUNTY BENTON
APPLICATION NO. GR-1888

OWNER: Oscar Kendall MAILING ADDRESS: 630 South Fourth
CITY AND STATE: Corvallis, Oregon

LOCATION OF WELL: Owner's No. #2
SW 1/4 NW 1/4 Sec. 12 T. 12 N. 5 E. W., W.M.

Bearing and distance from section or subdivision corner 800' E. and 1200' N.

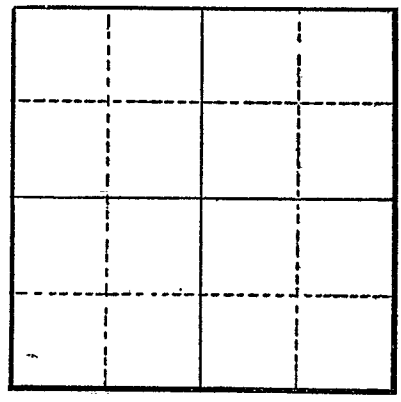

Section

Altitude at well

TYPE OF WELL: drilled Date Constructed 1912

Depth drilled 64 Depth cased

CASING RECORD:

10-inch

FINISH:

AQUIFERS:

WATER LEVEL:
18-feet

PUMPING EQUIPMENT: Type Fairbanks Morse Centrifugal H.P. 25
Capacity 550 G.P.M.

WELL TESTS:
Drawdown 2 ft. after hours Pumping 550 G.P.M.
Drawdown 2 ft. after hours Pumping 550 G.P.M.

USE OF WATER Irrigation Temp. °F., 19.....
SOURCE OF INFORMATION GR-2748

DRILLER or DIGGER

ADDITIONAL DATA:
Log Water Level Measurements Chemical Analysis Aquifer Test

REMARKS: