

STATE ENGINEER  
Salem, Oregon

# Well Record


Benton  
STATE WELL NO. 12/5W-12M  
COUNTY BENTON  
APPLICATION NO. GR-1887

OWNER: Oscar Kendall  
MAILING ADDRESS: 630 S. 4th

LOCATION OF WELL: Owner's No. #1  
CITY AND STATE: Corvallis, Oregon

NW 1/4 SW 1/4 Sec. 12 T. 12 N. 5 E. S., R. W., W.M.

Bearing and distance from section or subdivision corner 290' S. and 800' E.

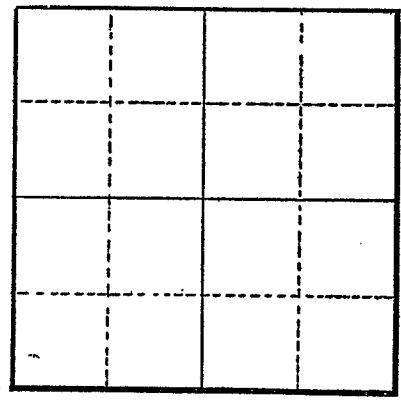

Altitude at well

TYPE OF WELL: drilled Date Constructed 1912

Depth drilled 64 Depth cased

Section

CASING RECORD:

10-inch

FINISH:

AQUIFERS:

WATER LEVEL:  
18-feet

PUMPING EQUIPMENT: Type Fairbanks Morse H.P. 25  
Capacity 550 G.P.M.

WELL TESTS:  
Drawdown 2 ft. after hours Pumping 550 G.P.M.  
Drawdown 2 ft. after hours Pumping 550 G.P.M.

USE OF WATER Irrigation Temp. °F., 19  
SOURCE OF INFORMATION GR-2747

DRILLER or DIGGER

ADDITIONAL DATA:  
Log Water Level Measurements Chemical Analysis Aquifer Test

REMARKS: