

STATE ENGINEER
Salem, Oregon

Well Record

Bent
5180


STATE WELL NO. 12/5W-12Q
COUNTY BENTON
APPLICATION NO. GR-2727

OWNER: Julius E. & Phyllis C. Purvine MAILING ADDRESS: Route 4

LOCATION OF WELL: Owner's No. #3 CITY AND STATE: Corvallis, Oregon

SW 1/4 SE 1/4 Sec. 12 T. 12 S., R. 5 W., W.M.

Bearing and distance from section or subdivision corner 1010.5' S. 28° 26' W.

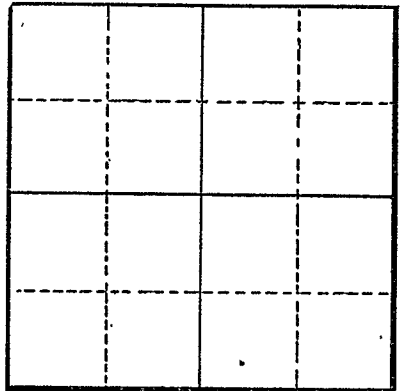

Section

Altitude at well

TYPE OF WELL: drilled Date Constructed 1947

Depth drilled 29 Depth cased 29

CASING RECORD:

10-inch

FINISH:

perforated, size and number unknown from 19' to 29'

AQUIFERS:

WATER LEVEL:

12-feet

PUMPING EQUIPMENT: Type Centrifugal H.P. 50
Capacity 800 G.P.M.

WELL TESTS:

Drawdown 1 ft. after hours Pumping 800 G.P.M.
Drawdown ft. after hours G.P.M.

USE OF WATER irrigation Temp. °F. 19

SOURCE OF INFORMATION GR-2580

DRILLER or DIGGER Bill Hamilton, Albany, Oregon

ADDITIONAL DATA:

Log Water Level Measurements Chemical Analysis Aquifer Test

REMARKS: