

STATE ENGINEER
Salem, Oregon

Well Record


Bent
5181
STATE WELL NO. 12/5W-12R
COUNTY BENTON
APPLICATION NO. GR-2732

OWNER: Julius E. & Phyllis C. Purvine
MAILING ADDRESS: Route 4

LOCATION OF WELL: Owner's No. _____
CITY AND STATE: Corvallis, Oregon

SE 1/4 SE 1/4 Sec. 12 T. 12 N. S., R. 5 E. W.M.

Bearing and distance from section or subdivision
corner 1335' S. 28° 20' E.

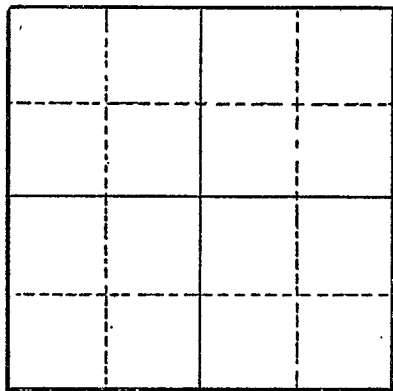

Altitude at well _____

TYPE OF WELL: drilled Date Constructed 1950

Depth drilled 30 Depth cased 30

Section _____

CASING RECORD:

10-inch

FINISH:

perforated, size and number unknown from 20 to 30

AQUIFERS:

WATER LEVEL:

12-feet

PUMPING EQUIPMENT: Type Centrifugal H.P. 30
Capacity 650 G.P.M.

WELL TESTS:

Drawdown 1 ft. after _____ hours Pumping 650 G.P.M.
Drawdown _____ ft. after _____ hours _____ G.P.M.

USE OF WATER irrigation Temp. _____ °F. _____, 19

SOURCE OF INFORMATION GR-2585

DRILLER or DIGGER Bill Hamilton, Albany, Oregon

ADDITIONAL DATA:

Log _____ Water Level Measurements _____ Chemical Analysis _____ Aquifer Test _____

REMARKS: