

STATE ENGINEER
Salem, Oregon

Well Record

Bent STATE WELL NO. 12/5W-22J(1)
5263 COUNTY Benton
APPLICATION NO. GR-272

OWNER: City of Corvallis

MAILING ADDRESS:

LOCATION OF WELL: Owner's No. #4


CITY AND STATE:

City Hall, Corvallis, Oregon

NE 1/4 SE 1/4 Sec. 22 T. 12 N. S, R. 5 W., W.M.

Bearing and distance from section or subdivision

corner S 18° 35' E. 2627' from NW corner of Samuel
Gage DLC #57 & S 54° 30' E 673' from SW corner
of Harvey Young DLC #56

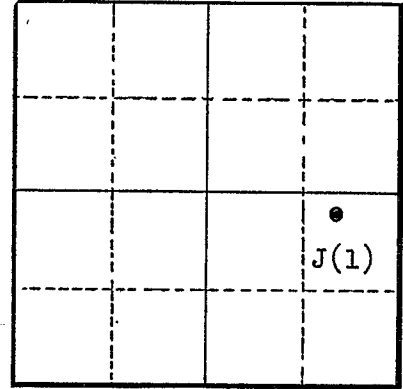

Altitude at well 240' Interpolated

TYPE OF WELL: Drilled Date Constructed 8/28/52 ?

Depth drilled 60 Depth cased unknown

Section 22

CASING RECORD:

8" depth unknown

FINISH:

unknown

AQUIFERS:

unknown

WATER LEVEL:

12' (estm) below land surface

PUMPING EQUIPMENT: Type Fairbanks Morse - Pomona Turbine H.P. 7 1/2
Capacity 120 G.P.M.

WELL TESTS:

Drawdown ? ft. after hours pumping 200 G.P.M.

Drawdown ft. after hours G.P.M.

USE OF WATER Municipal 120 gpm Temp. °F. 19

SOURCE OF INFORMATION Registration Statement GR-272

DRILLER or DIGGER Bill Howell Rt. 2, Philomath, Oregon

ADDITIONAL DATA:

Log No. Water Level Measurements Chemical Analysis Aquifer Test

REMARKS: