

STATE ENGINEER  
Salem, Oregon

# Well Record


Bent STATE WELL NO. 12/5W-22P(1)  
5264 COUNTY Benton  
APPLICATION NO. GR-272

OWNER: City of Corvallis MAILING ADDRESS: City Hall

LOCATION OF WELL: Owner's No. #3 CITY AND STATE: Corvallis, Oregon

SE 1/4 SW 1/4 Sec. 22 T. 12 S, R. 5 W., W.M.

Bearing and distance from section or subdivision corner N 16° 45' E 415' from SE corner of Alfred Rhinehart DLC #73 & N 07° 15' E 950' from SW corner of Samuel Gage DLC #57

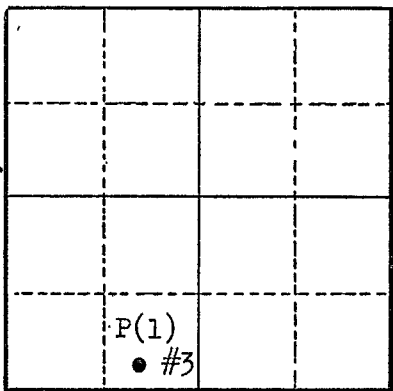

Altitude at well 240' Interpolated

TYPE OF WELL: Drilled Date Constructed August 1943

Depth drilled 46' Depth cased 46'

Section 22

### CASING RECORD:

8" set from 0 to 46'

### FINISH:

unknown - believed to be perforated between 30 and 46 feet

### AQUIFERS:

Gravel from 21 to 43 feet below land surface

### WATER LEVEL:

12 feet below land surface

PUMPING EQUIPMENT: Type Jacuzzi ejector H.P. 7 1/2  
Capacity 80 G.P.M.

### WELL TESTS:

Drawdown 30 ft. after pumping 80 hours G.P.M.  
Drawdown ft. after hours G.P.M.

USE OF WATER Municipal 80 gpm Temp. °F., 19  
SOURCE OF INFORMATION Registration Statement GR-272

DRILLER or DIGGER unknown

### ADDITIONAL DATA:

Log Yes Water Level Measurements Chemical Analysis Aquifer Test

### REMARKS:

**STATE ENGINEER**  
Salem, Oregon

State Well No. 12/5W-22 P(1)

County Benton

Application No. G 422

### Water Level Record

OWNER: City of Corvallis OWNER'S NO. \_\_\_\_\_

Description of measuring point: Owners air line and gage

Date	Water Level Feet (above) (below) Land Surface	Remarks	Date	Water Level Feet (above) (below) Land Surface	Remarks
10-6-58	25	Find Proof Survey			

REMARKS: \_\_\_\_\_  
\_\_\_\_\_  
\_\_\_\_\_

