


OWNER: *City of Corvallis* MAILING ADDRESS: *City Hall*

LOCATION OF WELL: Owner's No. *#1* CITY AND STATE: *Corvallis, Oregon*

SE $\frac{1}{4}$ *SE* $\frac{1}{4}$ Sec. *22* T. *12* S., R. *5* W., W.M.

Bearing and distance from section or subdivision corner *N. 53° 15' E. 2706' from SW corner of Samuel Gage DIC #57*

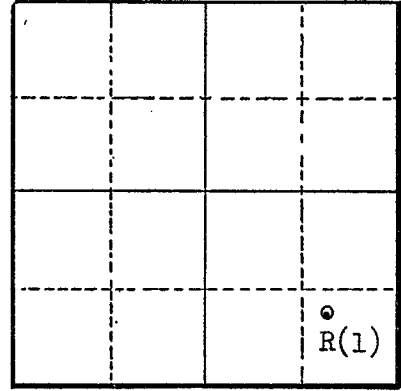

Altitude at well *210'* *Interpolated*

TYPE OF WELL: *Drilled* Date Constructed *Aug. '42*

Depth drilled *76* Depth cased *unknown*

Section *22*

CASING RECORD:

10" casing - depth unknown

FINISH:

unknown

AQUIFERS:

unknown

WATER LEVEL:

20' below land surface

PUMPING EQUIPMENT: Type *Jacuzzi* H.P. *7 1/2*
Capacity *80* G.P.M.

WELL TESTS:


USE OF WATER *Municipal 80 gpm* Temp. *19* °F.

SOURCE OF INFORMATION *Registration Statement GR-272*

DRILLER or DIGGER *unknown*

ADDITIONAL DATA:
Log *No* Water Level Measurements *No* Chemical Analysis *No* Aquifer Test *No*

REMARKS: