

STATE ENGINEER
Salem, Oregon


Well Record

STATE WELL NO. 12/5W-24H(1)
COUNTY Benton
APPLICATION NO. GR-226
5323

OWNER: W. L. Powell
MAILING ADDRESS: Route 3, Box 405
CITY AND STATE: Corvallis, Oregon

LOCATION OF WELL: Owner's No. 1
SE 1/4 NE 1/4 Sec. 24 T. 12 N. S. R. 5 E. W., W.M.

Bearing and distance from section or subdivision
corner 1100' W. and 700' N. from E 1/4
corner of Section 24.

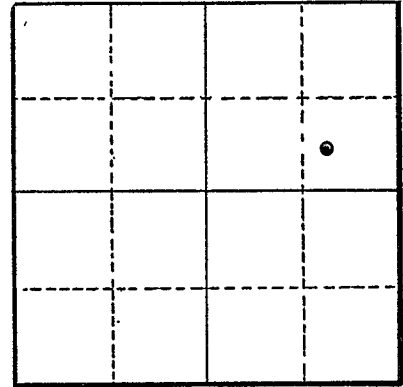

Section 24

Altitude at well 224' Interpolated

TYPE OF WELL: Dug Date Constructed 1920

Depth drilled 22 Depth cased 12

CASING RECORD:

10' diameter pit backfilled around
4" pipe which is set to 12'
3" pipe set from 12 to 22'

FINISH:

unknown

AQUIFERS:

Gravel from 0 to 22'

WATER LEVEL:

12' below land surface

PUMPING EQUIPMENT: Type Centrifugal 2 1/2" H.P. 7 1/2

Capacity 350 G.P.M.

WELL TESTS:

Drawdown 2 ft. after hours pumping 500 G.P.M.

Drawdown ft. after hours G.P.M.

USE OF WATER Irrigation 50 acres Temp. °F., 19

SOURCE OF INFORMATION Registration Statement GR-226

DRILLER or DIGGER

ADDITIONAL DATA:

Log No. Water Level Measurements Chemical Analysis Aquifer Test

REMARKS:

Gravel 0 to 22'
Kiger Island