


STATE ENGINEER
Salem, Oregon

Well Record *Bent* STATE WELL NO. 12/5W-24K(1)
5324 COUNTY Benton
APPLICATION NO. GR-617

OWNER: Robert E. McMahan MAILING ADDRESS: Route 3, Box 415

LOCATION OF WELL: Owner's No. CITY AND STATE: Corvallis, Oregon

NW 1/4 SE 1/4 Sec. 24 T. 12 S., R. 5 W., W.M.
Bearing and distance from section or subdivision
corner 505' S. 18° 20' E. of 1/2" iron pipe; said
pipe located the most northerly corner of
property of Lot 8 Island acres

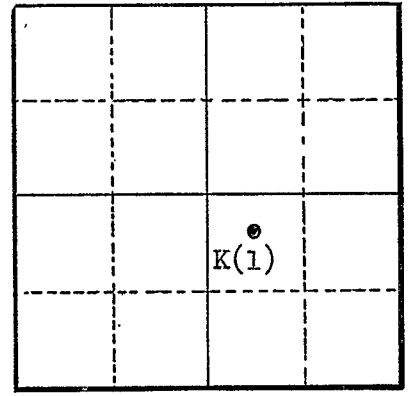

Section 24

Altitude at well 210

TYPE OF WELL: Driven Date Constructed 1951

Depth drilled 27 Depth cased 27

CASING RECORD:

2 1/2"

FINISH:

AQUIFERS:

WATER LEVEL:

15'

PUMPING EQUIPMENT: Type Centrifugal H.P. 3
Capacity 60 G.P.M.

WELL TESTS:

Drawdown 5 ft. after hours 45 G.P.M.
Drawdown ft. after hours G.P.M.

USE OF WATER Irrigation - 8 acres Temp. °F., 19

SOURCE OF INFORMATION GR-617

DRILLER or DIGGER -

ADDITIONAL DATA:

Log Water Level Measurements Chemical Analysis Aquifer Test

REMARKS: