

STATE ENGINEER  
Salem, Oregon

# Well Record

Bent  
5413  
STATE WELL NO. 12/5W-31C  
COUNTY BENTON  
APPLICATION NO. GR-1959

OWNER: Leonard Nitka


MAILING ADDRESS: Rt. 2 Box 193A

LOCATION OF WELL: Owner's No.

CITY AND STATE: Corvallis

NE 1/4 NW 1/4 Sec. 31 T. 12 S., R. 5 W., W.M.

Bearing and distance from section or subdivision  
corner 2784.5' E of NW corner of donation claim  
Nos. 66 and 42 and 413.5' S of N line of claims

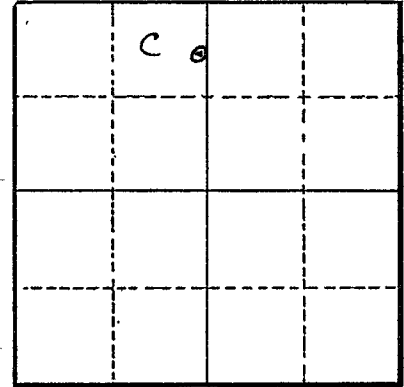

Section 31

Altitude at well

TYPE OF WELL: Drilled Date Constructed 1955

Depth drilled 94' Depth cased 94'

### CASING RECORD:

6-inch

### FINISH:

6 slits around pipe at 5 intervals 40' to 90'

### AQUIFERS:

Clay  
coarse sand

### WATER LEVEL:

15'

### PUMPING EQUIPMENT: Type Peerless turbine

H.P. 15

Capacity 240 G.P.M.

### WELL TESTS:

Drawdown 25 ft. after 150 hours G.P.M.

Drawdown 40 ft. after 225 hours G.P.M.

USE OF WATER Irrigation

Temp. °F. 19

SOURCE OF INFORMATION GR-3850

DRILLER or DIGGER NA

### ADDITIONAL DATA:

Log <sup>X</sup> Water Level Measurements Chemical Analysis Aquifer Test

### REMARKS:

Clay 40' to 40'  
coarse sand, water bearing 54' to 94'  
Clay at 94'