

STATE ENGINEER
Salem, Oregon

Well Record

Bent STATE WELL NO. 12/5W-31D
5416 COUNTY BENTON
APPLICATION NO. GR-2935

OWNER: Alfred H. Sedlak


MAILING ADDRESS: Rt 2 Box 193

LOCATION OF WELL: Owner's No.

CITY AND STATE: Corvallis, Oregon

NW 1/4 NW 1/4 Sec. 31 T. 12 S., R. 5 W., W.M.

Bearing and distance from section or subdivision corner 28.40 ch E & 4.5 ch S of NW cor of the Jacob Martin DLC #66

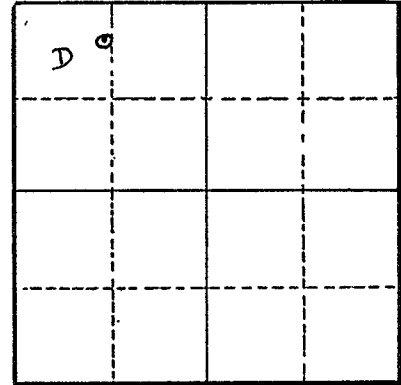

Section 31

Altitude at well

TYPE OF WELL: Drilled Date Constructed 1952

Depth drilled 75' Depth cased 65'

CASING RECORD:

6-inch

FINISH:

AQUIFERS:

WATER LEVEL:

30'

PUMPING EQUIPMENT: Type Red Jacket

H.P. 1 1/2

Capacity 30 G.P.M.

WELL TESTS:

Drawdown 40 ft. after hours 30 G.P.M.

Drawdown ft. after hours G.P.M.

USE OF WATER Irrigation Temp. °F., 19

SOURCE OF INFORMATION GR-3947

DRILLER or DIGGER

ADDITIONAL DATA:

Log NA Water Level Measurements Chemical Analysis Aquifer Test

REMARKS: