

STATE ENGINEER
Salem, Oregon


Well Record

Bent STATE WELL NO. 12/5W-31J(1)
COUNTY Benton
5417 APPLICATION NO. GR-622

OWNER: Leighton Davis MAILING ADDRESS: Route 2, Box 197
CITY AND STATE: Corvallis, Oregon

LOCATION OF WELL: Owner's No. 1
N. E.
NE 1/4 SE 1/4 Sec. 31 T. 12 S., R. 5 W., W.M.

Bearing and distance from section or subdivision
corner 419' S. 60° 50' W. from 1/4 corner

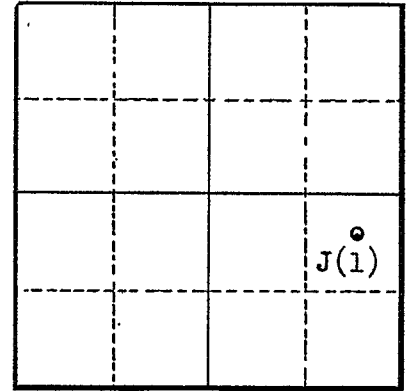

Section 31

Altitude at well 230

TYPE OF WELL: Drilled Date Constructed 1954

Depth drilled 120 Depth cased _____

CASING RECORD:

6"

FINISH:

AQUIFERS:

WATER LEVEL:

20'

PUMPING EQUIPMENT: Type Fairbanks Pamona Turbine H.P. 7 1/2
Capacity 170 G.P.M.

WELL TESTS:

Drawdown 30 ft. after _____ hours 170 G.P.M.
Drawdown _____ ft. after _____ hours _____ G.P.M.

USE OF WATER Irrigation 25 acres Temp. _____ °F. _____, 19____

SOURCE OF INFORMATION GR-622

DRILLER or DIGGER -

ADDITIONAL DATA:

Log Water Level Measurements _____ Chemical Analysis _____ Aquifer Test _____

REMARKS:

