

Bent
5656

OWNER: George Newman


MAILING ADDRESS: Route 2, Box 80 A

LOCATION OF WELL: Owner's No.

CITY AND STATE: Philomath, Oregon

SE 1/4 SE 1/4 Sec. 10 T. 12 S., R. 6 W., W.M.

Bearing and distance from section or subdivision corner 561' W. and 198' N.

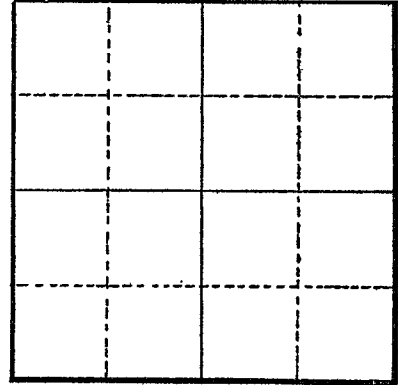

Section

Altitude at well

TYPE OF WELL: Date Constructed 1953

Depth drilled 42' Depth cased 36'

CASING RECORD:
6"

FINISH:

open bottom

AQUIFERS:

WATER LEVEL:

15'

PUMPING EQUIPMENT: Type Berkley Centrifugal H.P. 1 1/2
Capacity 20 G.P.M.

WELL TESTS:

Drawdown 15 ft. after hours pumping 10 G.P.M.

Drawdown ft. after hours G.P.M.

USE OF WATER Irrigation Temp. °F., 19

SOURCE OF INFORMATION GR-2948

DRILLER or DIGGER Bill Howell Philomath, Oregon

ADDITIONAL DATA:

Log Water Level Measurements Chemical Analysis Aquifer Test

REMARKS: