

STATE ENGINEER
Salem, Oregon

Well Record *Bent 5744*
STATE WELL NO. 12/6W-12A
COUNTY BENTON
APPLICATION NO. GR-3717

OWNER: Charles R. Bayless


MAILING ADDRESS: Philomath, Oregon

LOCATION OF WELL: Owner's No.

CITY AND STATE:

NE 1/4 NE 1/4 Sec. 12 T. 12 S., R. 6 W., W.M.

Bearing and distance from section or subdivision corner about 660' S & 1250' W from NE corner Sec 12

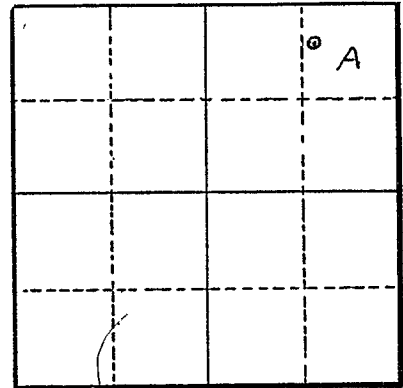

Section 12

Altitude at well

TYPE OF WELL: Drilled Date Constructed 1950

Depth drilled 170' Depth cased 84'

CASING RECORD:

10-inch

FINISH:

AQUIFERS:

WATER LEVEL: 140' / 145'

PUMPING EQUIPMENT: Type Lane Bowles H.P. 10
Capacity 80 G.P.M.

WELL TESTS:
Drawdown 170 ft. after hours 70 G.P.M.
Drawdown ft. after hours G.P.M.

USE OF WATER Irrigation Temp. °F., 19

SOURCE OF INFORMATION GR-3974

DRILLER or DIGGER

ADDITIONAL DATA:
Log ^X Water Level Measurements Chemical Analysis Aquifer Test

REMARKS:

